

Russell

Map No. KANSAS Sec. 24 Twp. 14 R. 15^w


Well No. 1 Bobberger Farm
Laris & Zube Company

330 Ft. from N. Line

_____ Ft. from S. Line

_____ Ft. from E. Line

330 Ft. from W. Line

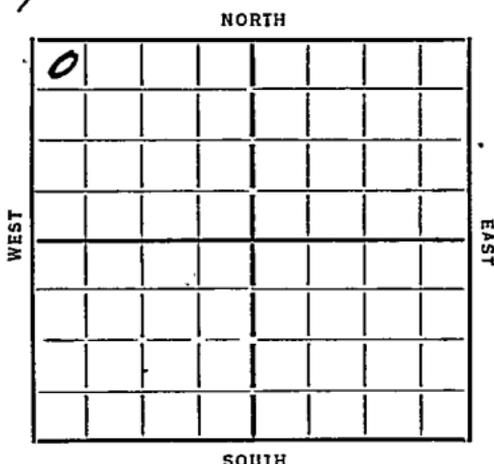

Date 12/24

REPORT

<u>12/12</u>	<u>Rig</u>	
<u>12/21</u>	<u>Rig</u>	
<u>12/27</u>	<u></u>	
<u>1/3/35</u>	<u>280</u>	<u>20" 81</u>
<u>1/19</u>	<u>" 760</u>	<u>15 1/2 377</u>
<u>4/17</u>	<u>" 1575</u>	<u>10" 872</u>
<u>1/24</u>	<u>" 2285</u>	
<u>1/31</u>	<u>" 2550</u>	<u>8" 2465</u>
<u>2/7</u>	<u>" 2795</u>	
<u>2/14</u>	<u>" 2795</u>	<u>8" 2790</u>
<u>2/21</u>	<u>" 3130</u>	
<u>2/28</u>	<u>" 3213</u>	<u>Asphalt 3015</u>
<u>3/7</u>	<u>5" 3245</u>	<u>Silicious 3263 3252</u>
	<u>T 7 3264 3253</u>	<u>2600' oil</u>
<u>3/14</u>	<u>P 515 Bble</u>	<u>24 hrs Sil 3252</u>
	<u>T 7 3253</u>	<u>Corrected</u>
<u>3/20</u>	<u>Silicious 3252</u>	<u>T 7 3255</u>
	<u>840 Bble</u>	<u>2% Water</u>

COMPLETED

Russell *W. S. J.*
 Map No. 72 Sec. 24 Twp. 14 R. 15W
 Well No. 1-Bohberger
Lario & Texas Company

FIRST REPORT Contractor

NWC

SECTION PLAT

330 Ft. from N. Line
 _____ Ft. from S. Line
 _____ Ft. from E. Line
330 Ft. from W. Line

0			

Location.....
 Rig up.....
 Drilling and Remarks:

Rig

RECORD

Cased..... in., * ft.
 Sand.....
 Gas.....
 Oil.....
 Total Depth.....

PRODUCTION

1st 24 hrs. Nat.....
 1st 24 hrs. after shot.....
 Gas..... Cu. Ft.
 Dry Hole.....
 Abandoned.....

Date

12-12-31 192.....

ORVAL MANNSCHRECK

Scout

Map No. 72 Sec. 24 Twp. 14 R. 15W

Well No. 1-Boyerberger
Lario & Texas Company

Contractor

COMPLETED

SECTION PLAT

0			

330 Ft. from N. Line

..... Ft. from S. Line

..... Ft. from E. Line

330 Ft. from W. Line

RECORD

Location.....

Rig up.....

Drilling and Remarks:

840 lbs
290 water

Cased..... in., ft.

Sand Siliceous 3252

Gas.....

Oil.....

Total Depth 3255

PRODUCTION

1st 24 hrs. Nat.....

1st 24 hrs. after shot.....

Gas..... Cu. Ft.

Dry Hole.....

Abandoned.....

ORVAL MANNSCHRECK

Date

3-20-35 192.....

Scout