KANSAS

FORM 51 5M 4-41 PETROL


Russell

Section 24 Township 14 Range 15-W

Well No. #3 Boxberger

Company John Lindas et al

Big Creek Pool

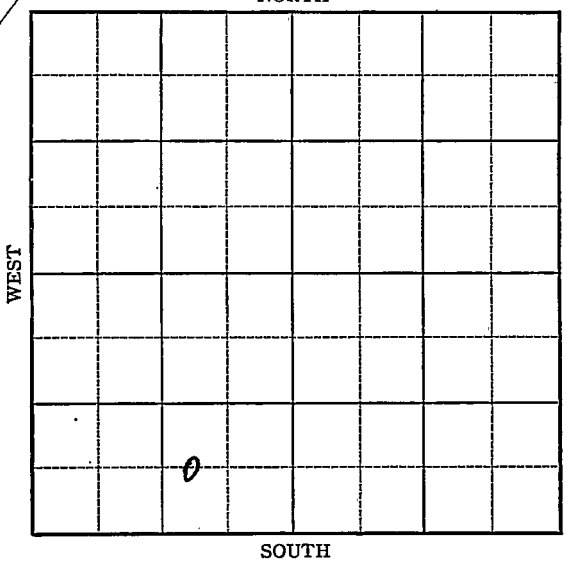

FORM 252-A 5M 1-41 PETROL KANSAS Russell

Sec. 24 Twp. 14 R. 15-W

Well No. #3 Boxberger Farm

John Lindas et al Company

(Big Creek)


____ Ft. from N. Line

660 Ft. from S. Line

990 Ft. from E. Line

____ Ft. from W. Line

Elev. 1794

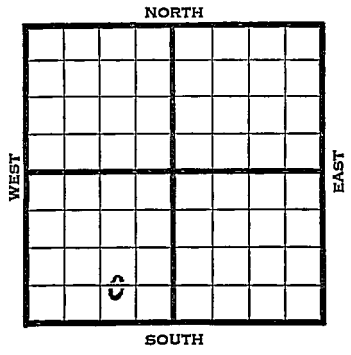

1941	REPORT
5/27	Location
6/5	8" - 830' WOC.
6/12	Anhy 820' Arb. 3202-07' T.D.
	5" - 3206' RUST.
6/19	Arb. 3200' (Corrected)
	5" - 3203' T.D. 3207'
	2800' oil 10 hours.
6/26	" " "
7/3	" " "
7/9	Arb. 3200'
	5" - 3203'
	T.D. 3207'
	1000 acid.
	Potential 439 bbls., pump.
	COMPLETED

Form 26—200 Bks.—1-40—Palace Russell KANSAS

Map No. 72 Sec. 24 Twp. 14 R. 15W

Well No. 3 Boxberger

John Lindas etal Company

FIRST REPORT Contractor

C W L SE SW

_____ Ft. from N. Line


660 Ft. from S. Line

990 Ft. from E. Line

_____ Ft. from W. Line

BIG CREEK POOL

SECTION PLAT

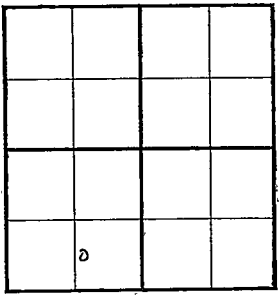

Location X

Rig up

Drilling and Remarks:

RECORD

Cased _____ in., _____ ft.

Sand

Gas

Oil

Total Depth

PRODUCTION

1st 24 hrs. Nat.

1st 24 hrs. after shot

Gas _____ Cu. Ft.

Dry Hole

Abandoned

Date

MAY 27 1941 19 S. J. LEWIS Scout

Form 26 200 Bks. 5-41 McW. Russell KANSAS

Map No. Sec. 24 Twp. 14 R. 15W

Well No. 3 Boxberger

John Lindas etal Company

Contractor

COMPLETED

C W L SE SW

Ft. from N. Line


660 Ft. from S. Line

990 Ft. from E. Line

Ft. from W. Line

BIG CREEK POOL

SECTION PLAT

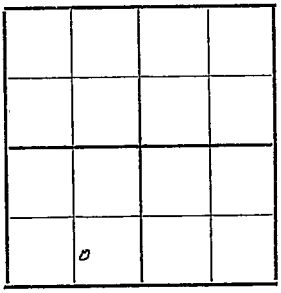

Location

Rig up

Drilling and Remarks:

Cr & 3200
5" @ 3203
1000 acid
Pump 439 Bbl.

RECORD

Cased in., ft.

Sand

Gas

Oil

Total Depth 3207

PRODUCTION

1st 24 hrs. Nat.

1st 24 hrs. after shot

Gas Cu. Ft.

Dry Hole

Abandoned

Date

JUL 9 1941 19 S. J. LEWIS Scout