


Section 24 - Township 14 Range 15W

Well No. #4 Boxberger

Company John Lindas et al

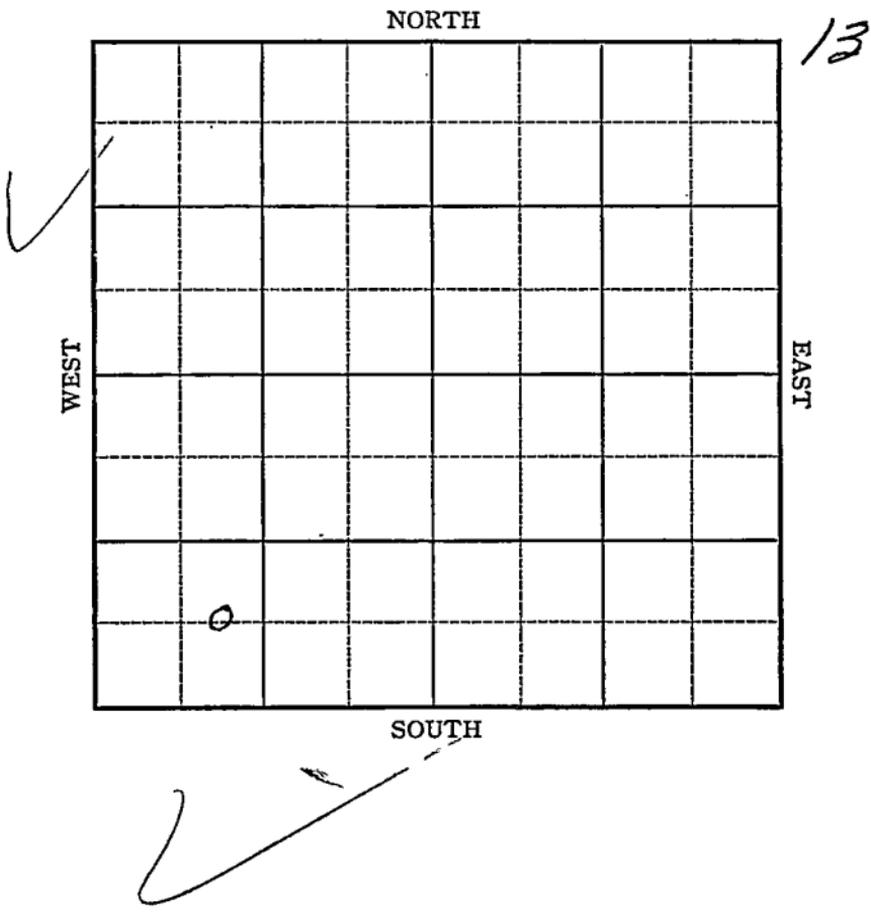

Sec. 24 Twp. 14 R. 15-W

Well No. #4 Boxberger Farm

John Lindas et al Company

(Big Creek)


 Ft. from N. Line

660 Ft. from S. Line

 Ft. from E. Line

990 Ft. from W. Line

Elev. 1789

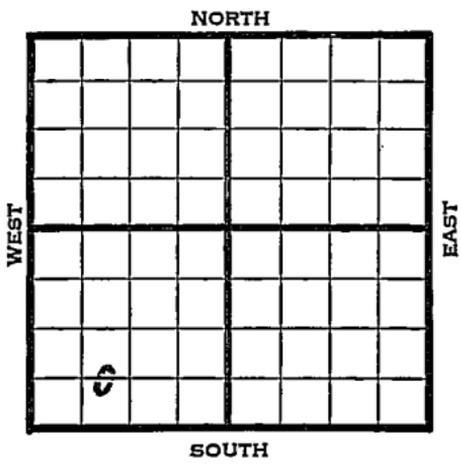

1941	REPORT
6/25	Derrick.
7/3	8" - 383' WOC.
7/10	Lans. 2952' Drlg. 3094'
7/17	Gorham 3308-10' T.D. 5" - 3308½'
	RUST.
7/24	TD 3231 200' water.
7/31	" " "
8/7	" " "
8/15	Plug back 3191½ SD
8/21	" " "
8/27	Gorham 3208'
	5" - 320.9½'
	T.D. 3231'
	Water.
	ABANDONED

Map No. _____ Sec. 24 Twp. 14 R. 15WWell No. 4 BoxbergerJohn Lindas etal Company

Contractor

FIRST REPORT

C E L SW SW

SECTION PLAT

o			

_____ Ft. from N. Line

660 Ft. from S. Line

_____ Ft. from E. Line

990 Ft. from W. Line**BIG CREEK POOL**

Location _____

Rig up _____

Drilling and Remarks:

Derrick**RECORD**

Cased _____ in., _____ ft.

Sand _____

Gas _____

Oil _____

Total Depth _____

PRODUCTION

1st 24 hrs. Nat. _____

1st 24 hrs. after shot _____

Gas _____ Cu. Ft.

Dry Hole _____

Abandoned _____

Date

JUN 25 1941 19S. J. LEWIS Scout

Map No. _____ Sec. 24 Twp. 14 R. 15WWell No. 4 BoxbergerJohn Lindas etal CompanyABANDONED Contractor

C E L SW SW

SECTION PLAT

0			

_____ Ft. from N. Line

660 Ft. from S. Line

_____ Ft. from E. Line

990 Ft. from W. Line

BIG CREEK POOL

Location _____

Rig up _____

Drilling and Remarks:

*See memo 3208**5" C 3209 1/2**Water*

RECORD

Cased _____ in., _____ ft.

Sand _____

Gas _____

Oil _____

Total Depth: 3231

PRODUCTION

1st 24 hrs. Nat. _____

1st 24 hrs. after shot _____

Gas _____ Cu. Ft.

Dry Hole _____

Abandoned _____

Date

AUG 27 1941₁₉S. J. LEWIS Scout