


Russell
KANSAS
15WSection 24 Township 14 Range 15WWell No. #1 Boxberger "C"Company Kingwood Oil

NORTH

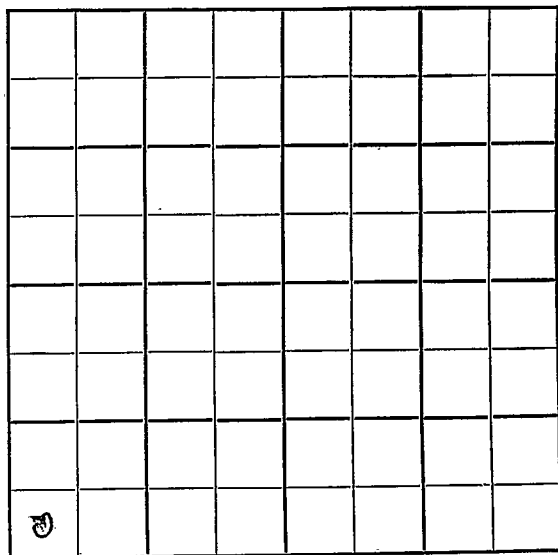

WEST

EAST

SOUTH

KANSAS
Russell

Sec. 24 Twp. 14 R. 15W ✓

Well No. #1 Boxberger "C" Farm

Kingwood Oil Company

Big Creek Pool Contractor


 Ft. from N. Line

330' Ft. from S. Line

 Ft. from E. Line

330' Ft. from W. Line

SW SW SW

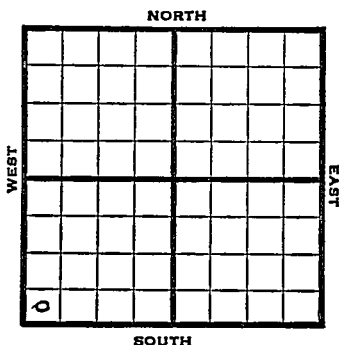

1950

Elev. 1785' REPORT

12/27

Drlg.

1951

1/17

Oil Well TD 3250
8" @ 834' Heeb. 2904
Sand 3206 Arb. 3219
TD 3250' 4" @ 3250
Perf/3212-14 FU 650' oil 1 hr
2500' oil 16 hr Comp. 50 bopd

COMPLETED

J. E. TYRA

County Russell State Kansas

Sec. 24 (Blk. Twp.) 14 (Sur. Rge.) 15W Map No.

Operator Kingwood Oil

Well No. 1 Farm Boxberger "C"

Elev.	1785	Location	SW SW SW
-------	------	----------	----------

0

COMPLETE

330 Ft. From S Line SW

330 Ft. From W Line Quarter

1st. Report

Completion JAN 17 1951

Remarks Big Creek Pool

Spudding Date

Drig. Data Oil well TD 3250

8" @ 834 Heeb. 2904 sand 3206

Arb. 3219 TD 3250 4" @ 3250

perf/ 3212-14 FU 650' oil 1 hr.

2500' oil 16 hr. Comp. 50 bopd

J. E. TYRA