

KANSASSection 24 Township 14 Range 15-WWell No. #1, H. MaiCompany ~~Kansas Elevator~~ Haynes + Mai

NORTH

WEST

EAST

SOUTH

						0	

16

Sec. 24 Twp. 14 R. 15W

Well No. 1 H. Mai Farm
Haynes & Mai
Kansas Elevator Company


Gorham Pool

 Ft. from N. Line

330 Ft. from S. Line

990 Ft. from E. Line

 Ft. from W. Line

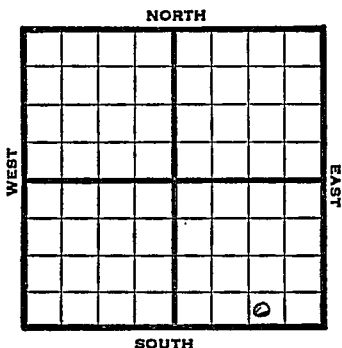

SW SE SE

REPORT

1947 Elev. 1812

1/8 Rig

1/15 "

1/21 "

1/30 Spud

2/5 15" @ 50'
12" @ 357
Drlg 7502'

2/12 Anhy 838
10" @ 840
Drlg 1615'

2/19 2480' run 8"

2/26 8" @ 2480'
Topeka 2685
SD 2688 and 2780-36
Dodge 2917 show free oil 2920-30
Drlg 2975'

3/4 Lans 2971'
7" @ 2971'
TD 2996
1000 Oil

OVER

3/12 Lans 2971'
7" @ 2971'
2000 Acid
Pump 350 Pot
Grav. 40
TD 2996'

COMPLETED

Map No. 72 Sec. 24 Twp. 14 R. 15W

Well No. 1 H. Mai

Kansas Elevator


Company

FIRST REPORT

Contractor

SW SE SE

SECTION PLAT

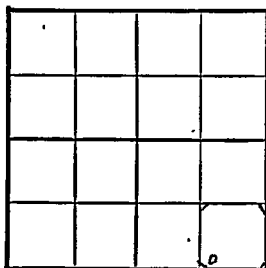

 Ft. from N. Line

330

Ft. from S. Line

990

Ft. from E. Line

 Ft. from W. Line

Russell County

Location

Rig up

Drilling and Remarks:

Rig

RECORD

Cased in., ft.

Sand

Gas

Oil

Total Depth

PRODUCTION

1st 24 hrs. Nat.

1st 24 hrs. after shot

Gas Cu. Ft.

Dry Hole

Abandoned

Date

JAN 8 1947 19

S. J. LEWIS

Scout

KANSAS

Map No. 7 Sec. 24 Twp. 14 R. 15WWell No. 1 H. MaiHaynes & Mai


Company

CORRECTION

Contractor

SW SE SE

SECTION PLAT

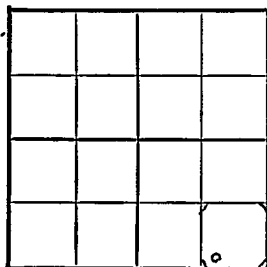 Ft. from N. Line330 Ft. from S. Line990 Ft. from E. Line Ft. from W. Line

Russell County

Location Rig up

Drilling and Remarks:

Reported

Kansas Elevator

RECORD

Cased in., ft.Sand Gas Oil Total Depth

PRODUCTION

1st 24 hrs. Nat. 1st 24 hrs. after shot Gas Cu. Ft.Dry Hole Abandoned

Date

JAN 22 1947

19

S. J. LEWIS

Scout

KANSAS
Kansas

Gorham Pool

Map No. 72 Sec. 24 Twp. 14 R. 15WWell No. 1 H. MaiHaynes & Mai Company


COMPLETE

Contractor

SW SE SE

E 11872

SECTION PLAT

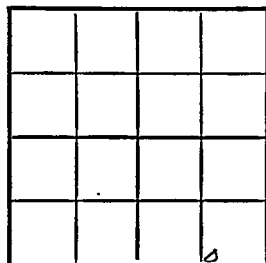 Ft. from N. Line330 Ft. from S. Line990 Ft. from E. Line Ft. from W. Line

Russell County

Location Rig up

Drilling and Remarks:

Loss 2871
7" @ 2871 "
2000 acil
Pump 350 R

402/991

RECORD

Cased in., ft.Sand Gas Oil Total Depth 2996

PRODUCTION

1st 24 hrs. Nat. 1st 24 hrs. after shot Gas Cu. Ft.Dry Hole Abandoned

Date

MAR 12 1947

19

S. J. LEWIS Scout