

KANSAS

Form 51-5M-7-40-Palace


Russell

Section 24 Township 14 Range 15-W

Well No. 1 J. P. Boxberger

Company John Lindas et al

NORTH Big Creek Pool

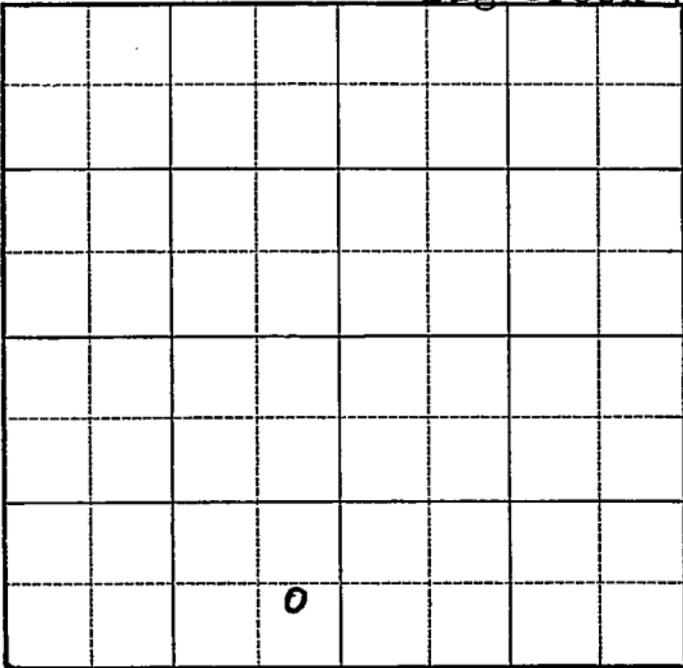

SOUTH

(Handwritten scribbles)

Sec. 24 Twp. 14 R. 15-W

Well No. #1 J. P. Boxberger Farm

John Lindas et al Company


(Big Creek)

_____ Ft. from N. Line

510 Ft. from S. Line

330 Ft. from E. Line

_____ Ft. from W. Line

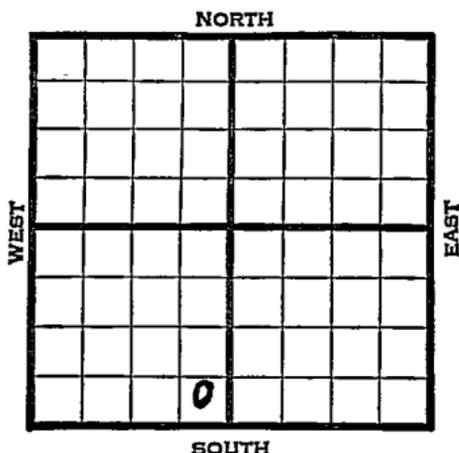

Elev. 1778

1941	REPORT
2/19	Bldg. Drk.
2/27	8" - 806' Drlg. 2041'
3/6	Shut down.
3/13	Ft. Riley 1720' Florence 1810' SD 2041'
3/20	Topeka 2670' Lans. 2945'
	Arb. 3133 ³¹⁸⁰ -86' T.D. Run csg.
3/27	Arb. 3180' (Corrected)
	5" - 3181' T.D. 3187'
	1800' oil 31 hours.
4/2	1000 acid. Pump 15 bbls. per hour.
4/10	" " "
4/18	" " "
4/24	" " "
	OVER

1941
4//30

Arb. 3180'

5" - 3181'

T.D. 3187'

1000 acid.

Depthograph potential 1763 bbls.

32. Gravity

COMPLETED

Map No. _____ Sec. 24 Twp. 14 R. 15WWell No. 1 J. P. BoxbergerJohn Lindas etal Company

Contractor

FIRST REPORT

C E L SE SW

_____ Ft. from N. Line

510 Ft. from S. Line330 Ft. from E. Line

_____ Ft. from W. Line

BIG CREEK POOL

SECTION PLAT

Location _____

Rig up _____

Drilling and Remarks:

Bldg. Derrick

RECORD

Cased _____ in., _____ ft.

Sand _____

Gas _____

Oil _____

Total Depth _____

PRODUCTION

1st 24 hrs.-Nat. _____

1st 24 hrs. after shot _____

Gas _____ Cu. Ft.

Dry Hole _____

Abandoned _____

Date

FEB 19 1941 19

S. J. LEWIS Scout

Map No. _____ Sec. 24 Twp. 14 R. 15WWell No. 1 J. P. BoxbergerJohn Lindas etal Company~~COMPLETED~~
~~DATE LISTED~~

Contractor

SECTION PLAT

C E L S E S W

_____ Ft. from N. Line

510 Ft. from S. Line330 Ft. from E. Line

_____ Ft. from W. Line

BIG CREEK POOL

Location _____

Rig up _____

Drilling and Remarks:

*Ch 8.3180**5" @ 3181**1000 aciol**Depth 241763**32 @ Gr***RECORD**

Cased _____ in., _____ ft.

Sand _____

Gas _____

Oil _____

Total Depth 3187**PRODUCTION**

1st 24 hrs. Nat. _____

1st 24 hrs. after shot _____

Gas _____ Cu. Ft.

Dry Hole _____

Abandoned _____

Date

APR 30 1941

19

S. J. LEWIS Scout