


Section 24 Township 14 Range 14-W

Well No. #8 Ebel "B"

Company Cities Service

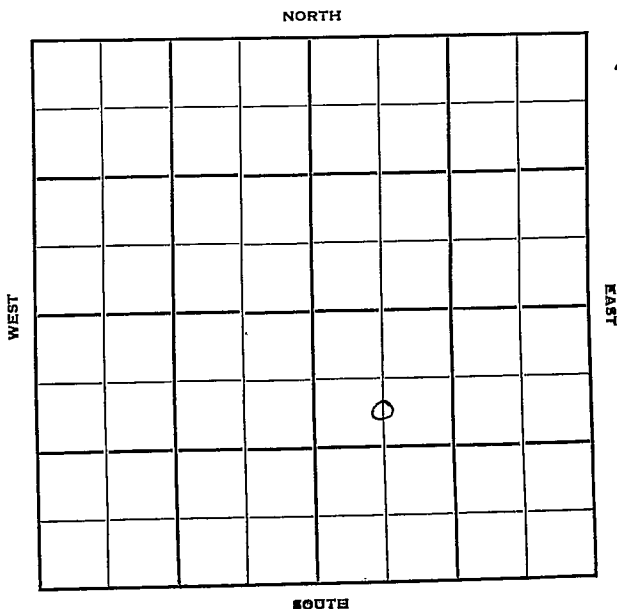

18

KANSAS

Russell

Sec. 24 Twp. 14 R. 14-W ✓

Well No. #8 Ebel "B" Farm

Cities Service

Company

Hall-Gurney

Contractor

990

Ft. from N. Line


Ft. from S. Line

Ft. from E. Line

660

Ft. from W. Line

C S L NW SE

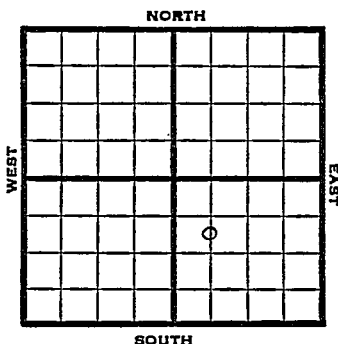

1950

Elev 1738

REPORT

8/2

Location

8/30

8" @ 360

Tarkio 2266

Top 2575

Heeb 2807

Dodge 2825

Lans 2870

Granite 3137-40

5" @ 3140

TD 3140

32/3082-90, 59/2965-80, 9/2910-13

32/2886-92

4250 A

Comp 196 bopd 35 bw

Completed

COMPLETED

Kansas

Map No. _____ Sec. 24 Twp. 14 R. 14WWell No. 8 Ebel "B"

_____ Cities Service _____ Company

_____ Contractor


C S L NW SE

SECTION PLAT

990 Ft. from N. Line

_____ Ft. from S. Line

_____ Ft. from E. Line

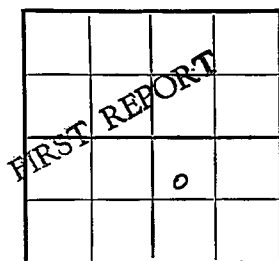660 Ft. from W. LineRussell CountyLocation X

Rig up _____

Drilling and Remarks:

RECORD

Cased _____ in., _____ ft.

Sand _____

Gas _____

Oil _____

Total Depth _____

PRODUCTION

1st 24 hrs. Nat. _____

1st 24 hrs. after shot _____

Gas _____ Cu. Ft.

Dry Hole _____

Abandoned _____

Date

AUG 2 1950 19J. E. TYRA Scout

J. E. TYRRA