


Section 24 Township 14 Range 14W

Well No. #9 Ebel "B"

Company Cities Service

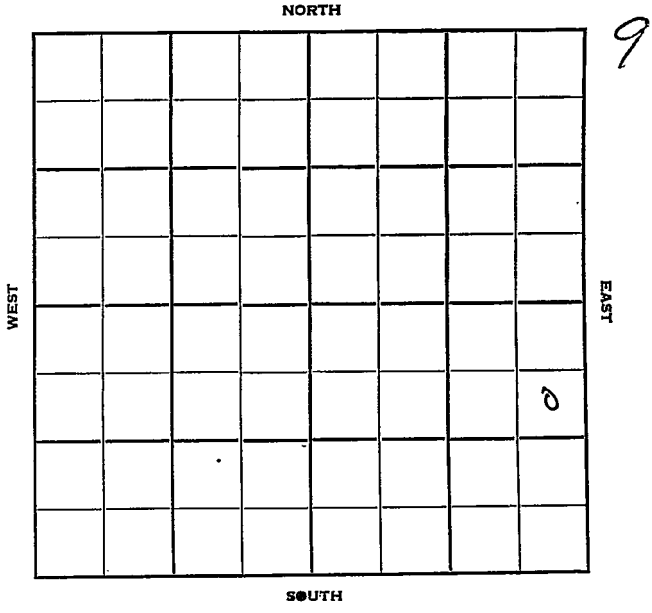

Sec. 24 Twp. 11 R. 11W

Well No. #9 Ebel "B" Farm

Cities Service Company

Contractor

Hall-Gurney Pool


990 Ft. from N. Line

_____ Ft. from S. Line

330 Ft. from E. Line

_____ Ft. from W. Line

SE NE SE

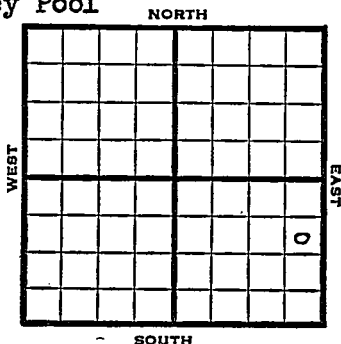

1952

Elev. 1753' REPORT

1/2

Spud 12-29-51
Drlg. 685'

2/6

Spud 12-29-51
Oil Well TD 2405
8" @ 750
1st Tar 2264 2nd Tar 2280
TD 2405 5" @ 2405 CO to 2377
105/ 2337-56 Hodry. S/ 70 bo
36 bw 18 hr. P/ 18 bo 17 bwpd
SP 2309 147/ 2284-2308 S/ 28 bo
14 hr. Hydro. CO to 2370 P
Comp. 79 bopd 18 bw

COMPLETED

