


Section 24 Township 14 Range 14W

Well No. #13 Ebel (B)

Company Cities Service Oil

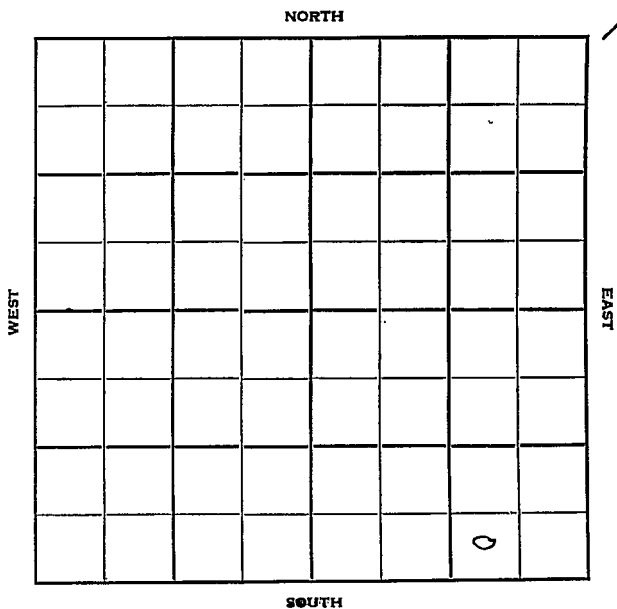

Sec. 24 Twp. 14 R. 14W

Well No. #13 EbeI (B) Farm

Cities Service Oil Company

Contractor


Ft. from N. Line

330 Ft. from S. Line

990 Ft. from E. Line

Ft. from W. Line

SW SE SE

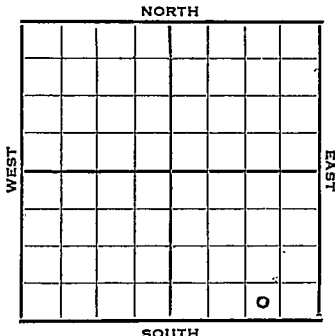

1952

Elev. 1727 REPORT

8/20

MI

8/27

10" @ 242 Tarkuo 2237
RTD 2368 7" @ 2368

9/3

CO 2329 117/2244-64

9/10

Spud 8-19-52
Oil Well TD 2368
10" @ 242 Tarkio 2237
TD 2368 7" @ 2368
CO to 2329 117/2244-64
Comp. 205 bopd

COMPLETED

