


Section 24 - Township 14 Range 14W

Well No. #17 Ebel (B) o

Company Cities Service Oil

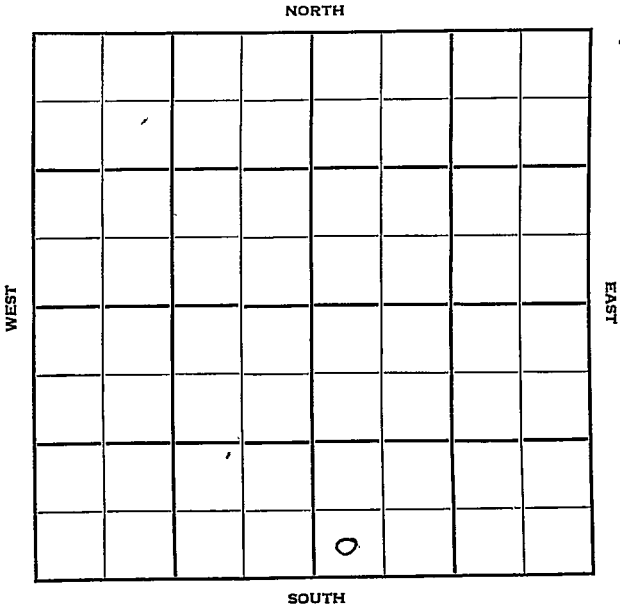

Sec. 24 Twp. 14 R. 14W

Well No. #17 Ebel (B) Farm

Cities Service Oil Company

Contractor

Ft. from N. Line

330'


Ft. from S. Line

Ft. from E. Line

330'

Ft. from W. Line

SW SW SE

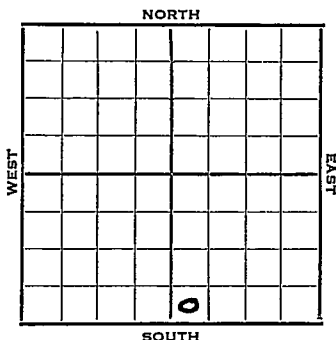

1952

Elev. 1748' REPORT

9/17

Spud 9-14-52

8" @ 202

Drlg. 1458

9/24

Tarkio 2263' 2nd Tarkio 2277'

RTD 2420' 4" @ 2420'

10/1

Spud 9-14-52

Oil well TD 2420' 8" @ 202

Tarkio 2263' 2nd Tarkio 2277'

TD 2420' 4" @ 2420 CO to 2388

33/2258-64 146/2269-94 Sd-frac.

Comp. 61 BOPD 6 BW

COMPLETED

