


FORM 51 25M 3-49 PETROL

Russell

Section 24 Township 14 Range 14 W

Well No. # 19 Ebel "B"

Company Cities Service Oil

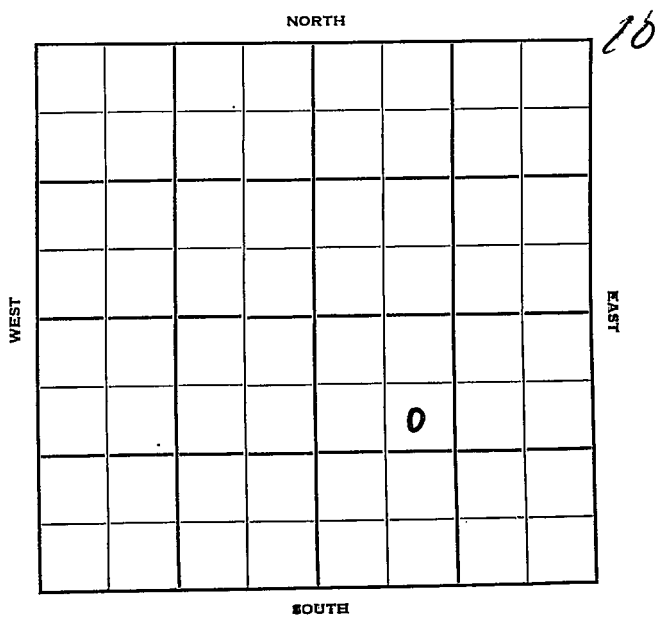

Russell

KANSAS



Sec. 24 Twp. 14 R. 14W

Well No. #19 Ebel "B" Farm _____

Cities Service Oil Company _____

Contractor _____

Hall-Gurney Pool


990 Ft. from N. Line

_____ Ft. from S. Line

_____ Ft. from E. Line

990 Ft. from W. Line

SE NW SE

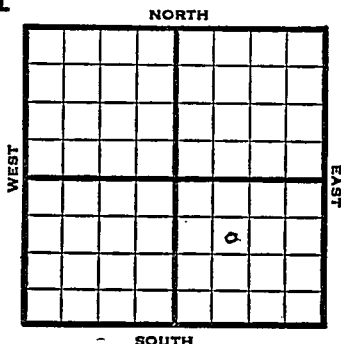

1952

Elev. 1731' REPORT

10/1 Spud 9-26-52
8" @ 202
Drlg. 2105

10/8 Tarkio 2248', 2nd Sd 2261'
TD 2398
4" @ 2398

10/15 77/2261-76, 20 gwph, Sd-frac

10/22 P/15 BO & 10 BWPD

10/29 PB 2258' 60/2246-56 Sd-frac.
CO 2355'

11/5 NR

11/12 "

11/20 "

11/26 Spud 9-26-52
Oil well TD 2398' 8" @ 202
1st Tarkio 2248' 2nd Tarkio 2261'
TD 2398 4" @ 2398 77/2261-76
20 GWPH Sd-frac P/15 BOPD 10 BW
PB 2258 60/2246-56 Sd-frac.
CO to 2355
Comp. 26 BOPD 12 BW

COMPLETED

