


Map No. KANSAS Sec. 24 Twp. 14 R. 14W
 Well No. #1 Adam Abel Farm _____
Empire O. & R Company _____

NORTH

WEST

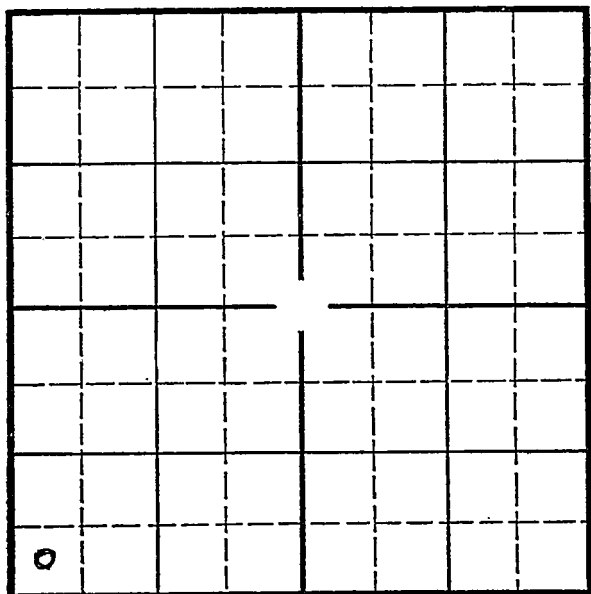

EAST

SOUTH

Location _____
 Drilling Remarks _____

Rig Up _____
 Drilling Remarks _____

RECORD

Cased _____ in. _____ ft.
 Sand _____
 Gas _____
 Oil _____
 Total Depth _____

PRODUCTION

1st 24 hrs. Nat. _____
 1st 24 hrs. after shot _____
 Gas _____ cu. ft. _____
 Dry Hole _____
 Abandoned _____

Map No. 72 Sec. 24 Twp. 14 R. 14WWell No. 1 Alam Del.Empire Oil & R. Company

Contractor

SECTION PLAT

.....Ft. from N. Line

320 Ft. from S. Line

.....Ft. from E. Line

320 Ft. from W. Line

FIRST REPORT

Location. ✓

Rig up.....

Drilling and Remarks:

RECORD

Cased.....in.,ft.

Sand.....

Gas.....

Oil.....

Total Depth.....

PRODUCTION

1st 24 hrs. Nat.....

1st 24 hrs. after shot.....

Gas.....Cu. Ft.

Dry Hole.....

Abandoned.....

Date

S. J. LEWIS

4/8/26 192.....

Scout

Map No. 72 Sec. 24 Twp. 14 R. 14W

Well No. 1 Calum O & G

Empire Company

Contractor

SECTION PLAT

0			

Ft. from N. Line

330 Ft. from S. Line

Ft. from E. Line

330 Ft. from W. Line

COMPLETED

Location

Rig up

Drilling and Remarks:

*Top Granite
Hole 3243*

Po 8/17/

RECORD

Cased _____ in., _____ ft.

Sand _____

Gas _____

Oil _____

Total Depth 3283

PRODUCTION

1st 24 hrs. Nat. _____

1st 24 hrs. after shot _____

Gas _____ Cu. Ft.

Dry Hole _____

Abandoned _____

Date

JUL 2. 1933

S. J. LEWIS

Scout