


Section 24 Township 14 Range 11W


Well No. #11 Dumler

Company Mrs. Alva Billings

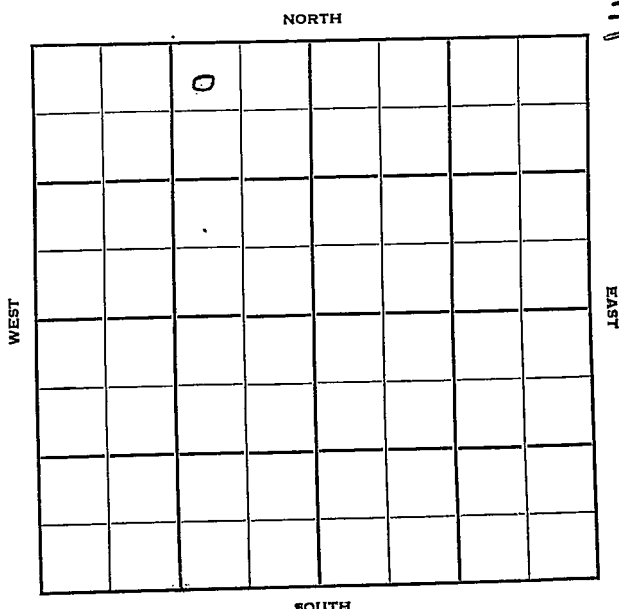

Russell

KANSAS

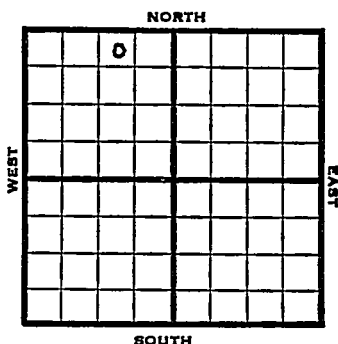Sec. 24 Twp. 14 R. 14WWell No. #11 Dumler FarmMrs. Alva Billings CompanyLewis Mai Contractor330 Ft. from N. Line Ft. from S. Line990 Ft. from E. Line Ft. from W. Line
NW $\frac{1}{4}$ NW NE NW

1952 Elev. 1778 ' REPORT

11/12 RUR

11/20 Drlg. 160'

11/27 Drlg. 965'

12/4 NR

12/11 Ø2280

12/18 Shut Down

12/25 Shut Down

1/1 Tarkio 2315 DD 2337 TD 18 Goph Hyd

1/8 NR

1/22 10 BOPD

1/29 NR

2/5 NR

2/12 NR

2/19 NR

2/26 NR

3/12 NR

3/19 NR

3/26 NR

4/2 CO 2337 Hyd.

4/8 Spud 11-16-53

Oil Well

OVER

1953

Information brought forward

4/8 Spud 11-16-53
 Oil Well
 TD 2337'
 Anhy 747,
 8" @ 753'
 Tarkio 2315,
 TD 2337
 18 goph Hydro.
 5" @ 2330
 CO to 2337
 10 bopd
 Comp. 100 bopd 3% wtr.

COMPLETED

County Russell State Kansas
 Sec. 24 (Blk.) 14 (Sur.) 14W Map No.

Operator Mrs. Alva Billings

Well No. 11 Farm Dumler

Elev. Location NW NE NW

	0				

FIRST REPORT

330 Ft. From N Line NW

990 Ft. From E Line Quarter

1st. Report NOV 12 1952

Completion

Remarks

Lewis Mai - Contr.

Spudding Date

Drlg. Data

RUR

Scout Cards _____

Land Small Map _____

Land Wall Map _____

Tracings _____

France Map _____

France Map _____

Misc. _____

NOV 14 1952

Drig. Data

County Russell State KansasSec. 24 (Blk.
Twp.) 14 (Sur.
Rge.) 14W Map No.Operator Mrs. Alva BillingsWell No. 11 Farm DumlerElev. 1778 Location NW NE NW

330 Ft. From N Line NW990 Ft. From E Line Quarter1st. ReportCompletion APR 8 1953RemarksLewis Mai - Contr.Spudding Date 11-16-53Drlg. Data Oil well TD 2337Anhy 747 8" @ 753 Tarkio 2315 TD 233718 goph Hydro. 5" @ 2330 CO to 233710 bopd Comp. 100 bopd 3% wtr.

APR 15 19

Scout Cards	RF
Land Small Map	
Land Wall Map	3
Tracings	
France Map	
Pierce Map	
Misc	

Drig. Date