

KANSAS

Russell


Form 51-5M-7-39-Palace

Section 24 Township 14 Range 14-W

Well No. #3 Ebel

Company Cities Service Oil

NORTH Gurney Pool 15

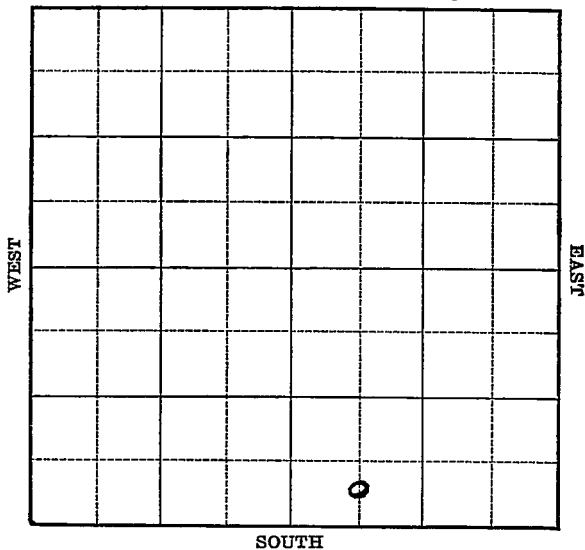

Map No. 72 Sec. 24 Twp. 14 R. 14WWell No. 3 Ebel

Cities Service Oil Company

Contractor

FIRST REPORT

C S L SW SE

SECTION PLAT

_____ Ft. from N. Line

330 Ft. from S. Line

_____ Ft. from E. Line

660 Ft. from W. Line

GURNEY POOL

Location X

Rig up _____

Drilling and Remarks:

RECORD

Cased _____ in., _____ ft.

Sand _____

Gas _____

Oil _____

Total Depth _____

PRODUCTION

1st 24 hrs. Nat. _____

1st 24 hrs. after shot _____

Gas _____ Cu. Ft.

Dry Hole _____

Abandoned _____

Date

JUN 5 1940₁₉S. J. LEWIS Scout

Map No. 72 Sec. 24 Twp. 14 R. 14WWell No. 3 EbelCities Service Oil Company

Contractor

COMPLETED
C S L SW SE**SECTION PLAT**

 Ft. from N. Line330 Ft. from S. Line Ft. from E. Line660 Ft. from W. Line

GURNEY POOL

Location Rig up

Drilling and Remarks:

*Leas. 2895**7" C 2892**10000 aced**Pump. 1315 28.***RECORD**Cased in., ft.Sand Gas Oil Total Depth 2928**PRODUCTION**1st 24 hrs. Nat. 1st 24 hrs. after shot Gas Cu. Ft.Dry Hole Abandoned

Date

JUL 2 1940 19S. J. LEWIS Scout