

Section 24 Township 14 Range 14W

Well No. 5 Dumler

Company Alva Billings

Hall-Gurney Pool  
NORTH

8

							0

WEST

EAST

SOUTH

Sec. 24 Twp. 14 R. 14W ✓

Well No. 5 Dumler Farm

Alva Billings Company


Hall-Gurney Pool

\_\_\_\_\_ Ft. from N. Line

330 Ft. from S. Line

330 Ft. from E. Line

\_\_\_\_\_ Ft. from W. Line

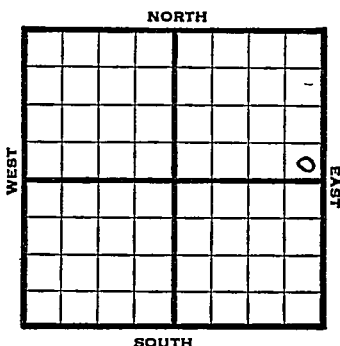

SE NE

1948 Elev. 1778' REPORT

9/22 Location  
9/29 RIG  
10/6 Drlg 300'  
10/13 15"@ 306'  
12"@ 427'  
Drlg 625'  
10/19 Drlg 1770'  
10/26 8"@ 2050'  
2055 700' oil / 900' W  
11/3 Indian Cave Sd 2054'  
Flow 50 bbls oil PH - 16 hrs  
11/10 "  
11/17 Indian Cave 2054'  
8" @ 2050'  
Pump 700 oil Pot.  
Gr. 40.9  
TD 2055'

**COMPLETED**

Russell County Kansas StateMap No. \_\_\_\_\_ Sec. 24 Twp. 14 R. 14WWell No. 5 DumlerAlva Billings CompanyFIRST REPORT Contractor

SE NE

## SECTION PLAT

\_\_\_\_\_ Ft. from N. Line

330 Ft. from S. Line330 Ft. from E. Line

\_\_\_\_\_ Ft. from W. Line

							o

Hall-Gurney Pool

Remarks:

Location

Date  
SEP 22 1948

Scout S. J. LEWIS

