


Section 24 Township 14 Range 14-W

Well No. #6 Dumlér

Company Alva Billings

Hall-Gurney Pool
NORTH

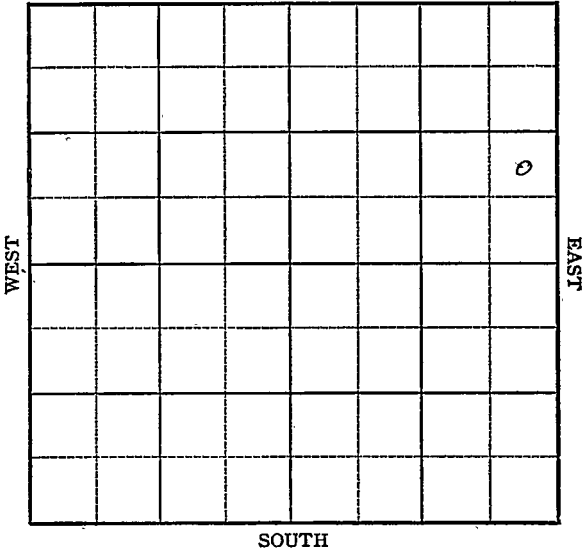

8

Russell KANSAS ✓

Sec. 24 Twp. 14 R. 14W

Well No. #6 Dumler Farm

Alva Billings Company

Billings Contractor

Hall-Gurney Pool


Ft. from N. Line

990' Ft. from S. Line

330' Ft. from E. Line

Ft. from W. Line

NE SE NE

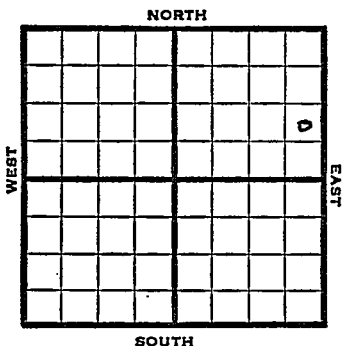

1949 Elev. 1773' REPORT

11/9	Location
11/16	15" @ 300'
	13" @ 425'
	10" @ 744'
	Drlg 780'
11/23	Drlg 1200'
11/29	Drlg 2270'
12/7	Drlg 2432'
12/14	Tarkio 2392'
	7" @ 2389'
	Acid 1000'
	Pump 60 oil & 10 W Pot.
	Gr. 40.9°
	TD 2432'

COMPLETED

Map No. _____ Sec. 24 Twp. 14 R. 14W

Well No. 6 Dumler

Alva Billings

Company

Billings

Contractor

NE SE NE

**FIRST REPORT
SECTION PLAT**

_____ Ft. from N. Line

990 Ft. from S. Line

330 Ft. from E. Line

_____ Ft. from W. Line

			o

Russell County

Location X

Rig up _____

Drilling and Remarks: _____

RECORD

Cased _____ in., _____ ft.

Sand _____

Gas _____

Oil _____

Total Depth _____

PRODUCTION.

1st 24 hrs. Nat. _____

1st 24 hrs. after shot _____

Gas _____ Cu. Ft.

Dry Hole _____

Abandoned _____

Date

NOV 9 1949

19

S. J. LEWIS

Scout

Kansas

Map No. _____ Sec. 24 Twp. 14 R. 14WWell No. 6 DumlérAlva Billings

Company

COMPLETE

Contractor


NE SE NE

E1.1773
SECTION PLAT

_____ Ft. from N. Line

990 Ft. from S. Line330 Ft. from E. Line

_____ Ft. from W. Line

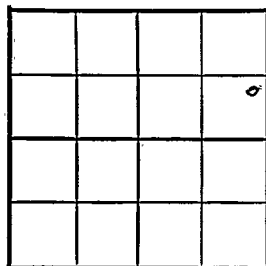

Russell County

Location _____

Rig up _____

Drilling and Remarks:

*Mar bit 2392**7" @ 2389**1000 acid**Pump 60 oil + 10 W**Pat**40 E***RECORD**

Cased _____ in., _____ ft.

Sand _____

Gas _____

Oil _____

Total Depth 2482**PRODUCTION**

1st 24 hrs. Nat. _____

1st 24 hrs. after shot _____

Gas _____ Cu. Ft.

Dry Hole _____

Abandoned _____

Date

DEC 14 1949 19S. J. LEWIS

Scout