

KANSAS

Form 51-5M-7-40-Palace


Russell

Section 24 Township 14 Range 14-W

Well No. #2 Ebel "A"

Company Cities Service Oil

Hall Pool

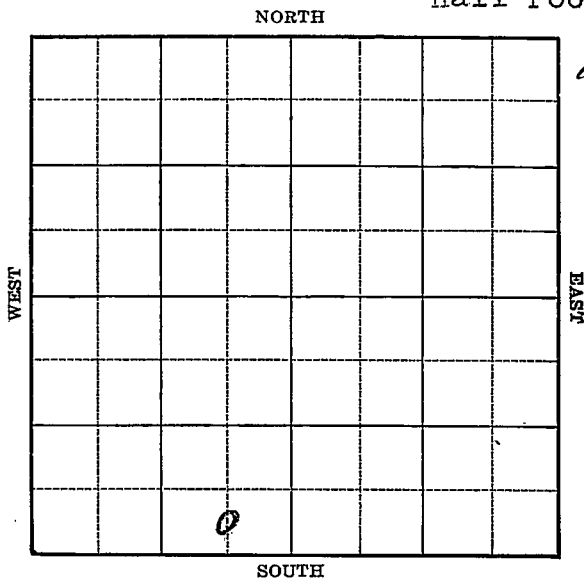

KANSAS

Russell

Sec. 24 Twp. 14 R. 14W

Well No. 2-Ebel "A" Farm _____

Cities Service Oil Company
(Hall Pool) NORTH


_____ Ft. from N. Line

330 Ft. from S. Line

660 Ft. from E. Line

_____ Ft. from W. Line

Elev. 1772

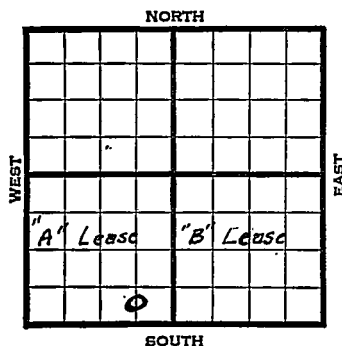

1940	REPORT
8/28	Location
9/5	8" - 299' Dr lg. 2280'
9/12	Lans. 2912' Granite wash 3172 ³¹⁷² '
	T.D. 3188 ³¹⁸⁸ ' 5" - 3185 ³¹⁸³ ' RUST.
9/18	Granite wash 3172' (Corrected)
	5" - 3183'
	T.D. 3188'
	108 shots 3001-3188'
	8000 acid.
	Pump 947 oil plus 9% water.
	COMPLETED

Map No. _____ Sec. 24 Twp. 14 R. 14W

Well No. 2 Ebel "A"

Cities Service Oil Company

Contractor _____

FIRST REPORT
C S L SE SW

SECTION PLAT

_____ Ft. from N. Line

330 Ft. from S. Line

660 Ft. from E. Line

_____ Ft. from W. Line

Hall Pool

Location X

Rig up _____

Drilling and Remarks:

RECORD

Cased _____ in., _____ ft.

Sand _____

Gas _____

Oil _____

Total Depth _____

PRODUCTION

1st 24 hrs. Nat. _____

1st 24 hrs. after shot _____

Gas _____ Cu. Ft.

Dry Hole _____

Abandoned _____

Date

AUG 28 1940

S. J. LEWIS Scout

Map No. 72 Sec. 24 Twp. 14 R. 14WWell No. 2 Ebel "A"

Cities Service Oil

Company

Contractor

COMPLETED

C S L SE SW

_____ Ft. from N. Line

330 Ft. from S. Line660 Ft. from E. Line

_____ Ft. from W. Line

SECTION PLAT

HALL POOL

Location _____

Rig up _____

Drilling and Remarks:

*Grants Wash.**3172. Corrected.**5" C3183**108 Shots 3001-3188**8000 acid**Pump 947 oil**+ 9% water*

RECORD

Cased _____ in., _____ ft.

Sand _____

Gas _____

Oil _____

Total Depth 3188

PRODUCTION

1st 24 hrs. Nat. _____

1st 24 hrs. after shot _____

Gas _____ Cu. Ft.

Dry Hole _____

Abandoned _____

Date

SEP 18 1940 19

S. J. LEWIS Scout