

Russell


KANSAS

FORM 51 5M 10-41 PETROL

Section 24 Township 14 Range 14-W

Well No. #3 Ebel "A"

Company Cities Service Oil

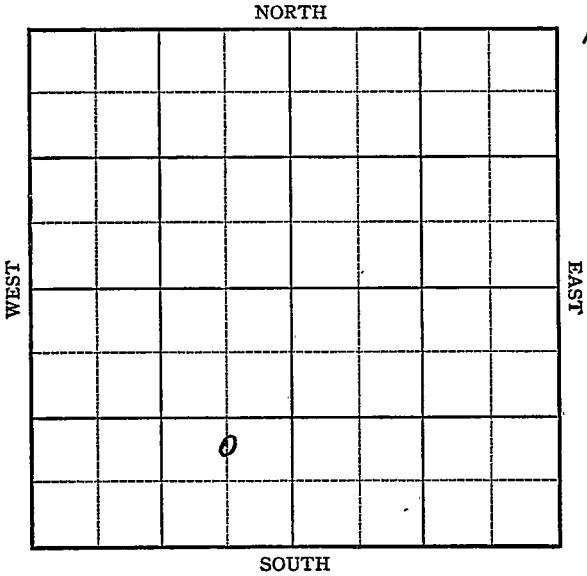

Map No. K-112 Sec. 24 Twp. 14 R. 14WWell No. 3 Ebel "A"Cities Service Oil Company**FIRST REPORT**

Contractor

C NL SE SW

SECTION PLAT

	0		

_____ Ft. from N. Line

990 Ft. from S. Line660 Ft. from E. Line

_____ Ft. from W. Line

HALL GURNEY POOL

Location _____

Rig up _____

Drilling and Remarks:

8" - 322'

1320' Drlg.

RECORD

Cased _____ in., _____ ft.

Sand _____

Gas _____

Oil _____

Total Depth _____

V PRODUCTION

1st 24 hrs. Nat. _____

1st 24 hrs. after shot _____

Gas _____ Cu. Ft.

Dry Hole _____

Abandoned _____

Date

NOV 19 1941

19

S. J. LEWIS Scout

Russell

KANSAS

Map No. 72 Sec. 24 Twp. 14 R. 14WWell No. 3 Ebel "A"Cities Service Oil CompanyCOMPLETED Contractor

C NL SE SW

SECTION PLAT

	o		

_____ Ft. from N. Line

990 Ft. from S. Line660 Ft. from E. Line

_____ Ft. from W. Line

HALL GURNEY POOL

Location _____

Rig up _____

Drilling and Remarks:

Liams 2919
5" @ 2940
5000 acid
Pump 333 oil
+ 12 Water
39 @ 32

RECORD

Cased _____ in., _____ ft.

Sand _____

Gas _____

Oil _____

Total Depth 2965

PRODUCTION

1st 24 hrs. Nat. _____

1st 24 hrs. after shot _____

Gas _____ Cu. Ft.

Dry Hole _____

Abandoned _____

Date

DEC 17 1941 19

S. J. LEWIS Scout