


Section 25 Township 14 Range 16-W

Well No. 1 J. A. Baumrucker

Company Continental

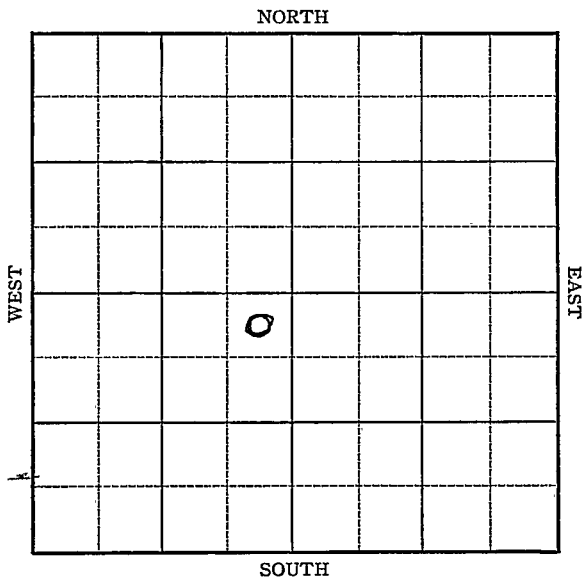

Map No. _____ Sec. 25 Twp. 14 R. 16W

Well No. 1 J.A. Baumrucker

Continental

Company

Contractor

FIRST REPORT

NE SW

SECTION PLAT

330 Ft. from N. Line

_____ Ft. from S. Line

330 Ft. from E. Line

_____ Ft. from W. Line

	0		

Location _____

Rig up _____

Drilling and Remarks:

Cellar

RECORD

Cased _____ in., _____ ft.

Sand _____

Gas _____

Oil _____

Total Depth _____

PRODUCTION

1st 24 hrs. Nat. _____

1st 24 hrs. after shot _____

Gas _____ Cu. Ft.

Dry Hole _____

Abandoned _____

Date

NOV 3 1937₁₉

H. D. Hatfield

Scout

Ellis **KANSAS**Map No. 71 Sec. 25 Twp. 14 R. 16WWell No. 1 J. A. Baumrucker
Continental Company

Contractor

ABANDONED**SECTION PLAT**

NE SW

330 Ft. from N. Line Ft. from S. Line330 Ft. from E. Line Ft. from W. Line

	0		

Location Rig up

Drilling and Remarks:

D & A

RECORDCased in. ft.Sand cong 3290Gas sil 3364Oil Total Depth 3394**PRODUCTION**1st 24 hrs. Nat. 1st 24 hrs. after shot Gas Cu. Ft.Dry Hole Abandoned

Date

DEC 15 1937 19 H. D. Hatfield Scout