

O. W. D. D.

RUSSELL

Form 51-5M-3-35-Mid-West

Map No. **KANSAS** Sec. **25** Twp. **14** R. **15-W**
 Well No. **#1-Ehrlick** (Ehrlich) Farm
Skelly Oil Company

NORTH

7

WEST

EAST

SOUTH

Location _____

Drilling Remarks _____

Rig Up _____

Drilling Remarks _____

RECORD

Cased _____ in. _____ ft.

Sand _____

Gas _____

Oil _____

Total Depth _____

PRODUCTION

1st 24 hrs. Nat. _____

1st 24 hrs. after shot _____

Gas _____ cu. ft. _____

Dry Hole _____

Abandoned _____

O.W.D.D. Russell

Form 252-A
5M 7-35 MPGMap No. KANSAS Sec. 25 Twp. 14 R. 15^WWell No. 1- Ehrlich FarmSkelly Oil Company


Ft. from N. Line

330 Ft. from S. Line

Ft. from E. Line

330 Ft. from W. Line

Elev. 1751

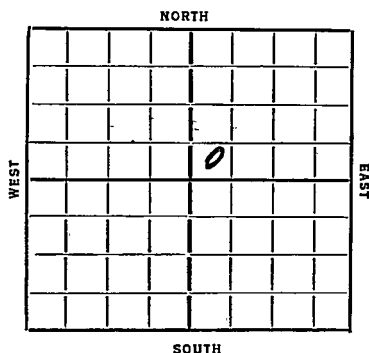

REPORT

~~1936~~
3/11 B. R.
3/13 --
3/20 --
3/27 12" - 475 WOC.
4/2 Drlg. 1350'
4/10 Drlg. 2765'
4/16 Oswald 2918' Cement 8".
4/23 T.D., 2950' 450' oil 5 hours. 1000 acid.
4/30 330* oil & 46 water Pump. S.D.
5/7 Drlg. 3100'.
5/14 S.O. and G. 3147-52'. U.R. 6".
5/21 --
5/28 Gorham 3152'. Pay 3152'-54'. T.D. 2800' oil.
6/3/36-Gorham 3152'. T.D. 3157'.
1116 Pot. Nat.

COMPLETED

OVER

Map No. 72 Sec. 25 Twp. 14 R. 15WWell No. 1- EhlichSkelly oil Company

Contractor

FIRST REPORTS

SECTION PLAT

Ft. from N. Line

330 Ft. from S. Line

Ft. from E. Line

330 Ft. from W. Line

		0	

Location.....

Rig up.....

Drilling and Remarks:

RECORD

Cased.....in.,ft.

Sand.....

Gas.....

Oil.....

Total Depth.....

PRODUCTION

1st 24 hrs. Nat.....

1st 24 hrs. after shot.....

Gas.....Cu. Ft.

Dry Hole.....

Abandoned.....

Date

3-11-36 192 ORVAL MANNSCHRECK Scout

KANSAS

Map No. 72 Sec. 25 Twp. 14 R. 15WWell No. 1 EhrlichSkelly Company

Contractor

SECTION PLAT

_____ Ft. from N. Line

330 Ft. from S. Line

_____ Ft. from E. Line

330 Ft. from W. Line

COMPLETED

Location _____

Rig up _____

Drilling and Remarks:

Boham 3/52.1116 PofNat.

RECORD

Cased _____ in., _____ ft.

Sand _____

Gas _____

Oil _____

Total Depth 3157

PRODUCTION

1st 24 hrs. Nat. _____

1st 24 hrs. after shot _____

Gas _____ Cu. Ft.

Dry Hole _____

Abandoned _____

Date

JUN 3 1936S. J. LEWIS Scout

O. W. D. D.

FORM 513 REV. SUNRAY

OWDD for SWD

County Russell Elev. 1751Sec. 25 Twp. 14 Rge. 15WCompany Skelly OilFarm Name A. Ehrlich No. 1

TOPS

DEPTH

LOG

DATUM

Loc. in Sec.


Geol.

Contr.

Pool

Gorham

FEB 22 '55
0

FIRST REPORT

Date Comm.

7" @ 3151 OTD 3157 DD 3264 2000 A

ran 192' of 4" liner @ 3192 CO to 3264

Took 197 br in 33 min.

OADD for SWD

County Russell Elev. 1751
 Sec. 25 Twp. 14 Rge. 15W
 Company Skelly Oil
 Farm Name A. Ehrlich No. 1

TOPS	DEPTH	LOG	DATUM	Loc. in Sec.
Asb				SW SW NE
TP				
H				
T				
D				
AL				
L				
KC	2916		1165	Geol.
RXC				Centre
Ca.				
C				
M				Pool
K				Gorham
Ma				
Na				
V				
S				
A	3117		1396	
R				
PE				
G				
TR				ABANDONED

Date Comm.

FEB 29 1956

7" @ 3151 OTD 3157 DD 3264 2000 A
 ran 192' of 4" liner @ 3192 CO to 3264
 Took 197 bw in 33 min. FEB 29 '56

COMP. SWD