

KANSAS

Section 25 Township 14 Range 15W

Well No. 9 Ehrlich

Company Skelly


Big Creek NORTH

2




WEST

EAST

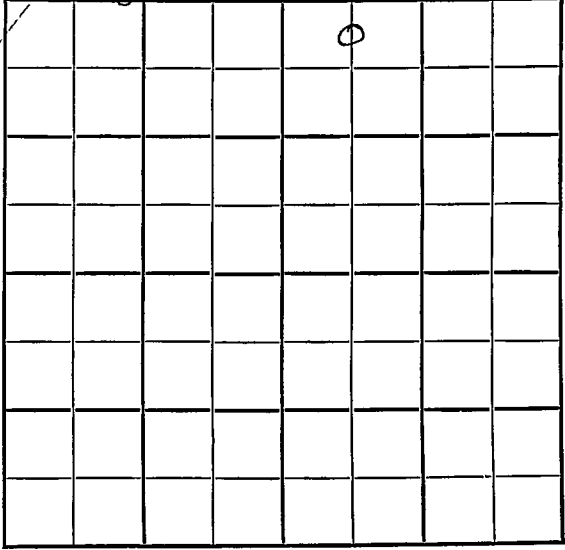

SOUTH

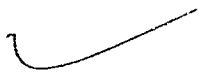

KANSAS

Russell

Sec. 25 Twp. 14 R. 15-W

Well No. #9 Ehrlich Farm

Skelly Company

Big Creek Pool


330' Ft. from N. Line

_____ Ft. from S. Line

_____ Ft. from E. Line

660' Ft. from W. Line

C N L NW NE

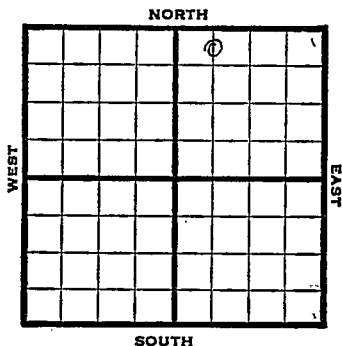

1947

Elev. 1763' REPORT

- 11/12 Location
- 11/19 13" @ 107'
Drlg. 200'
- 11/25 8" @ 794'
Drlg. 2185'
- 12/3 Heebner 2858'
Lansing 2917'
TD 2920'
Run 5"
- 12/10 5" @ 2919'
RUST
- 12/30 Lans. 2917'
5" @ 2919'
4000 acid
Pump 286 Pot
37.0 Gr.
TD 3020'

COMPLETED

Map No. _____ Sec. 25 Twp. 14 R. 15W

Well No. 9 Ehrlich

Skelly FIRST REPORT Company

Contractor

C N L NW NE

SECTION PLAT

330 Ft. from N. Line

_____ Ft. from S. Line

_____ Ft. from E. Line

660 Ft. from W. Line

		o	

Russell County

Location X

Rig up

Drilling and Remarks:

RECORD

Cased _____ in., _____ ft.

Sand _____

Gas _____

Oil _____

Total Depth _____

PRODUCTION

1st 24 hrs. Nat. _____

1st 24 hrs. after shot _____

Gas _____ Cu. Ft.

Dry Hole _____

Abandoned _____

Date

NOV 12 1947 19

S. J. LEWIS Scout

Map No. 72 Sec. 25 Twp. 14 R. 15W

Well No. 9 Ehrlich

Skelly Company

COMPLETE

Contractor

C N L NW NE

E11763
SECTION PLAT

330 Ft. from N. Line

_____ Ft. from S. Line

_____ Ft. from E. Line

660 Ft. from W. Line

		o	

Russell County

RECORD

Location _____

Cased _____ in., _____ ft.

Rig up _____

Sand _____

Drilling and Remarks:

Gas _____

Oil _____

Line 2917

Total Depth 2020

5" @ 298

4000 acid

PRODUCTION

1st 24 hrs. Nat. _____

1st 24 hrs. after shot _____

Gas _____ Cu. Ft.

Dry Hole _____

Abandoned _____

Pump 286 Pot.

22 3/4

Date

DEC 30 1947 19

S. J. LEWIS Scout