

LANSAP


Russell

Form 51-5M-4-36-Palace

Section 25 Township 14 Range 15-W

Well Number 2-Reinhardt


Company National Ref.

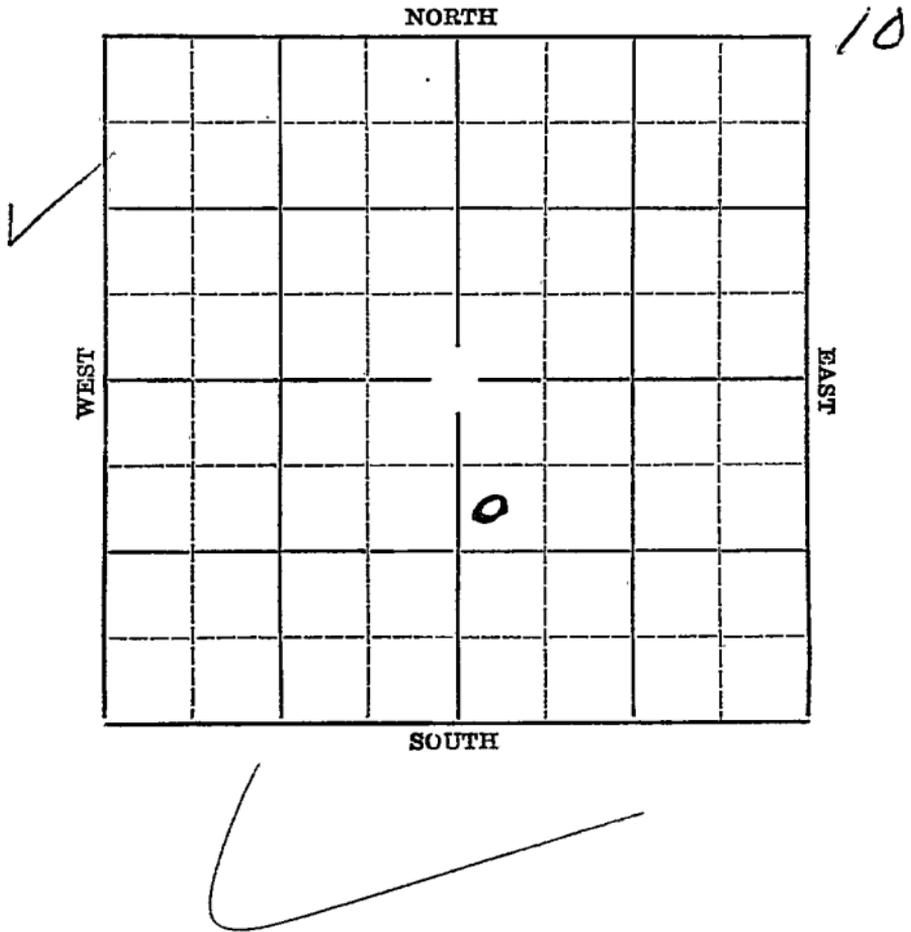

Map No. KANSAS Sec. 25 Twp. 14 R. 15W

Well No. #2 Reinhardt Farm \_\_\_\_\_  
National Ref. \_\_\_\_\_ Company \_\_\_\_\_

990' Ft. from N. Line  
\_\_\_\_ Ft. from S. Line  
\_\_\_\_ Ft. from E. Line  
290' Ft. from W. Line  
Elev. 1743

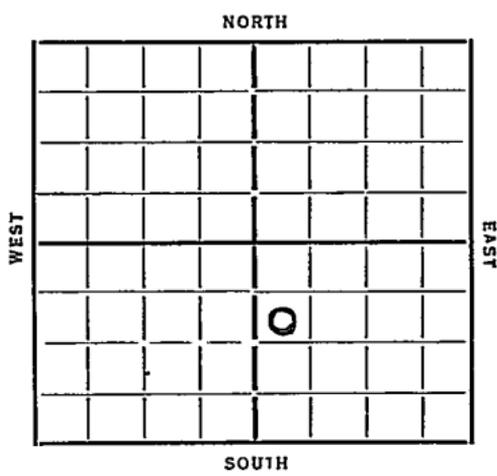

Date	REPORT
1936	
5/6	Location.
5/14	--
5/21	Building rig.
5/28	-- 6/4--
6/11	Spud 66'.
6/18	Drlg. 315'.
6/25	Drlg. 770'.
7/2	Drlg. 1730'.
7/9	Drlg. 2360'.
7/16	2815'. Topeka 2670'.
7/23	Lansing 2917'. Gorham 3156'. Oil 3156-71'. TD/
7/30	Total depth 3172'. Pump 842 bbls in 22 hours.
8/5/36	Gorham 3156'.
	T.D. 3161'.
	3000 gallons of acid.
	Pot. 942 bbls of oil in 21 hours
	<b>COMPLETED</b>

KANSAS

Map No. 72 Sec. 25 Twp. 14 R. 15WWell No. 2 ReinhardtNational Ref. Company

Contractor

## SECTION PLAT

990 Ft. from N. Line

..... Ft. from S. Line

..... Ft. from E. Line

290 Ft. from W. Line

		a	

## FIRST REPORT

Location ✓

Rig up .....

Drilling and Remarks:

## RECORD

Cased.....in., .....ft.

Sand.....

Gas.....

Oil.....

Total Depth.....

## PRODUCTION

1st 24 hrs. Nat.....

1st 24 hrs. after shot.....

Gas.....Cu. Ft.

Dry Hole.....

Abandoned.....

Date

MAY 6 1936 192S. J. LEWIS Scout

*Russell*

**KANSAS**

Map No. 72 Sec. 25 Twp. 14 R. 15W

Well No. 2 Reinhardt

National Ref. Company

Contractor

**SECTION PLAT**

990 Ft. from N. Line

\_\_\_\_\_ Ft. from S. Line

\_\_\_\_\_ Ft. from E. Line

290 Ft. from W. Line

		0	

**UNCOMPLETED**

Location \_\_\_\_\_

Rig up \_\_\_\_\_

Drilling and Remarks:

*Gas has 8156  
3000 acid  
Prod 942 oil  
21 hrs.*

**RECORD**

Cased \_\_\_\_\_ in., \_\_\_\_\_ ft.

Sand \_\_\_\_\_

Gas \_\_\_\_\_

Oil \_\_\_\_\_

Total Depth 3161

**PRODUCTION**

1st 24 hrs. Nat. \_\_\_\_\_

1st 24 hrs. after shot \_\_\_\_\_

Gas \_\_\_\_\_ Cu. Ft.

Dry Hole \_\_\_\_\_

Abandoned \_\_\_\_\_

Date

AUG 5 1936 19

S. J. LEWIS Scout