


Section 25 Township 14 Range 15-W

Well Number #3-Reinhardt "C"

Company National Ref.

NORTH

15

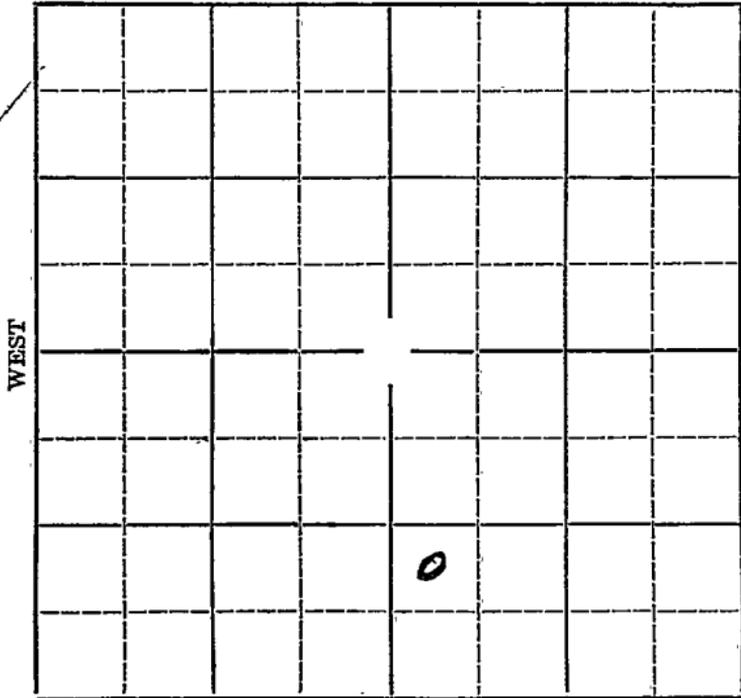

SOUTH

✓

Map No. KANSAS Sec. 25 Twp. 14 R. 15W

Well No. #3 Reinhardt "C" Farm

National Ref. Company


_____ Ft. from N. Line

990' Ft. from S. Line

_____ Ft. from E. Line

330' Ft. from W. Line

Elev. 1742

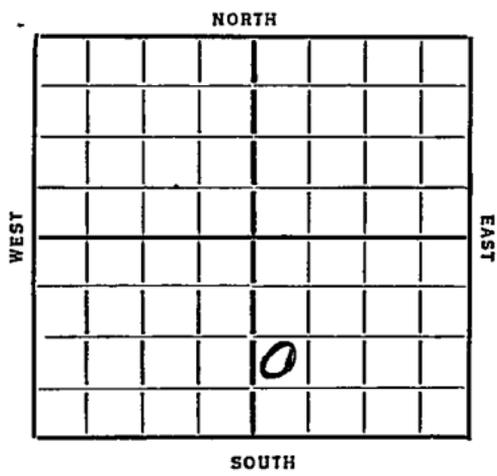

Date
1936
7/29
8/6
8/13
8/20
8/27
9/3
9/23/36

REPORT

Location
Rig on ground.
Rigging up.
Driving surface pipe.
12" @ 465'. anhydrate 744'. 10" @ 750'. Drlg. 1105'.
Drlg. 2115'.
36-Gorham 3150'.
T.D. 3157½'.
Potential 1886 bbls of oil.

COMPLETED

Map No. 72 Sec. 25 Twp. 14 R. 15WWell No. 3 Reinhardt "C"National Ref Company

Contractor

SECTION PLAT

		0	

_____ Ft. from N. Line

990 Ft. from S. Line

_____ Ft. from E. Line

330 Ft. from W. Line

FIRST REPORT

Location ✓

Rig up _____

Drilling and Remarks:

RECORD

Cased _____ in., _____ ft.

Sand _____

Gas _____

Oil _____

Total Depth _____

PRODUCTION

1st 24 hrs. Nat. _____

1st 24 hrs. after shot _____

Gas _____ Cu. Ft.

Dry Hole _____

Abandoned _____

Date

JUL 29 1936 19

S. J. LEWIS Scout

KANSAS

Map No. 72 Sec. 25 Twp. 14 R. 15W.Well No. 3 Reinhardt CoNational Ref. Company

Contractor

SECTION PLAT

		0	

_____ Ft. from N. Line

990 Ft. from S. Line

_____ Ft. from E. Line

830 Ft. from W. Line**COMPLETE**

Location _____

Rig up _____

Drilling and Remarks:

See log 3150Per 1886

RECORD

Cased _____ in., _____ ft.

Sand _____

Gas _____

Oil 1 0 -1Total Depth 3157 1/2

PRODUCTION

1st 24 hrs. Nat. _____

1st 24 hrs. after shot _____

Gas _____ Cu. Ft.

Dry Hole _____

Abandoned _____

Date

SEP 23 1936 19

S. J. LEWIS Scout