

KANSAS

Russell


Form 51-5M-7-40-Palace

Section 25 Township 14 Range 14-W

Well No. #2 Hickey

Company Cities Service Oil

NORTH ^{*} Trapp Pool *15*

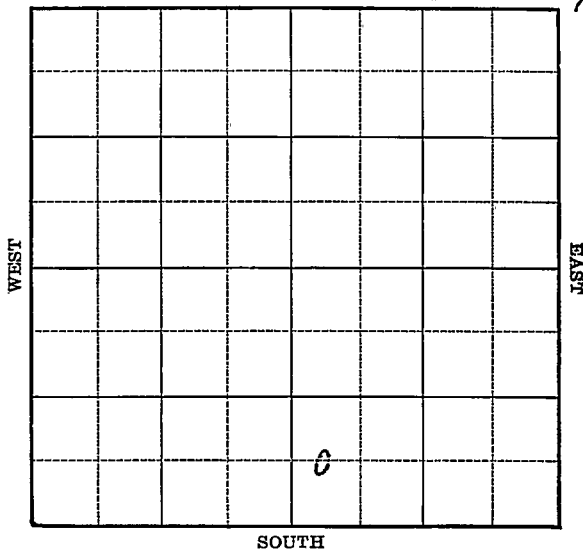

1940
11/6

Granite Wash 3134'

5" - 3139'

T.D. 3214'

P.B. to 3144'

108 shots 2920-3131'

5000 acid.

Pump 525 oil & 226 water.

COMPLETED

Map No. 72 Sec. 25 Twp. 14 R. 14W

Well No. 2 Hickey

Cities Service Oil Company

Contractor

FIRST REPORT
C W L SW SE

SECTION PLAT

_____ Ft. from N. Line

660 Ft. from S. Line

_____ Ft. from E. Line

330 Ft. from W. Line

		o	

TRAPP POOL

Location X

Rig up _____

Drilling and Remarks:

RECORD

Cased _____ in., _____ ft.

Sand _____

Gas _____

Oil _____

Total Depth _____

PRODUCTION

1st 24 hrs. Nat. _____

1st 24 hrs. after shot _____

Gas _____ Cu. Ft.

Dry Hole _____

Abandoned _____

Date

SEP 25 1940 19

S. J. LEWIS Scout

Misc Small Maps	<i>RAY</i>
Cards	<i>RAY</i>
Tracing	<i>Jno</i>
France Map	<i>RAY</i>
Centrough Map	<i>Jno</i>
Geological Dept.	
Moody	

Map No. 72 Sec. 25 Twp. 14 R. 14W

Well No. 2 Hickey

Cities Service Oil Company

Contractor

COMPLETED

C W L SW SE

_____ Ft. from N. Line

660 Ft. from S. Line

_____ Ft. from E. Line

330 Ft. from W. Line

TRAPP POOL

SECTION PLAT

Location _____

Rig up _____

Drilling and Remarks:

Granite Wash 3134

5" @ 3139

P.B. 3144

108 shots 2920-3131

5000 aciol

Pump 525 oil and 6

226 Water P.S.

RECORD

Cased _____ in., _____ ft.

Sand _____

Gas _____

Oil _____

Total Depth 3214

PRODUCTION

1st 24 hrs. Nat. _____

1st 24 hrs. after shot _____

Gas _____ Cu. Ft.

Dry Hole _____

Abandoned _____

Date

NOV 6 1940 19

S. J. LEWIS

Scout

