


Section 25 Township 14 Range 14W

Well No. 4 Hickey

Company Cities Service Oil

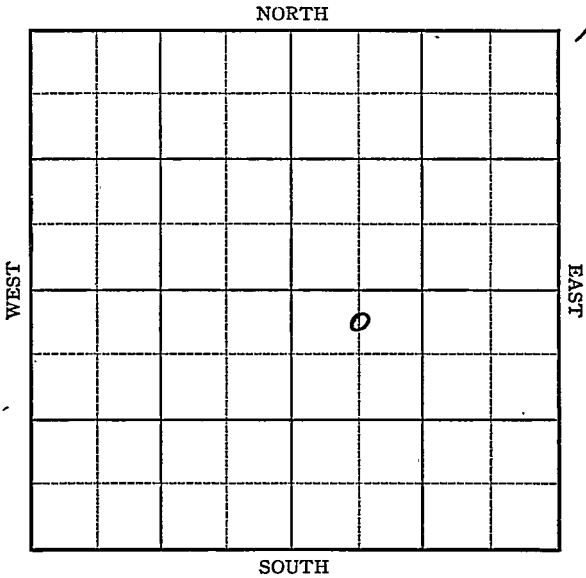

Map No. 72 Sec. 25 Twp. 14 R. 14W

Well No. 4 Hickey

Cities Service Oil Company

Contractor

FIRST REPORT

SECTION PLAT

C N L NW SE

330 Ft. from N. Line

_____ Ft. from S. Line

_____ Ft. from E. Line

660 Ft. from W. Line

		9	

HALL GURNEY POOL

Location _____

Rig up _____

Drilling and Remarks:

Derrick

RECORD

Cased _____ in., _____ ft.

Sand _____

Gas _____

Oil _____

Total Depth _____

PRODUCTION

1st 24 hrs.-Nat. _____

1st 24 hrs. after shot _____

Gas ← _____ Cu. Ft.

Dry Hole _____

Abandoned _____

Date

JUN 11 1941

19

S. J. LEWIS Scout

Map No. _____ Sec. 25 Twp. 14 R. 14W

Well No. 4 Hickey

Cities Service Oil Company

COMPLETED Contractor

SECTION PLAT

		o	

330 C N L NW SE
Ft. from N. Line

_____ Ft. from S. Line

_____ Ft. from E. Line

660 Ft. from W. Line

HALL GURNEY POOL

Location _____

Rig up _____

Drilling and Remarks:

*Lans 2896
Granite 3190
6 4/8 hd to .2932 -99
5000 rasol
Pump 789 oil
+ 78 Water Pst
383 4/4*

RECORD

Cased _____ in., _____ ft.

Sand _____

Gas _____

Oil _____

Total Depth 3192

PRODUCTION

1st 24 hrs. Nat. _____

1st 24 hrs. after shot _____

Gas _____ Cu. Ft.

Dry Hole _____

Abandoned _____

Date

JUL 9 1941 19 _____ S. J. LEWIS Scout