

KANSAS

Form 51-5M-11-38-Palace

O. W. D. D

Russell


Section 25 Township 14 Range 14-W

Well No. #3 B-Rein

Company Stanolind

NORTH Gurney Pool

4

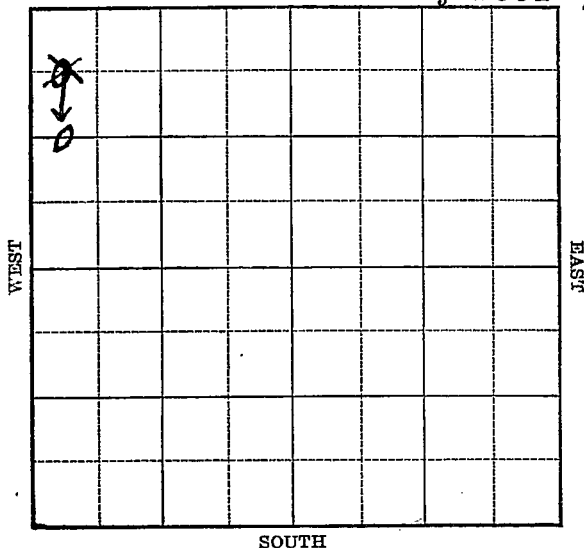

KANSAS

Russell

Sec. 25 Twp. 14 R. 14-W

Well No. #3 B. Rein Farm

Stanolind

Company

(Gurney)

O. W. D. D

NORTH

~~660~~ 1320

Ft. from N. Line


Ft. from S. Line

Ft. from E. Line

330

Ft. from W. Line

Elev. 1780

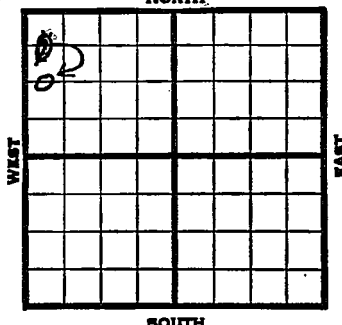

REPORT

1939

10/25

Location

11/2

Cable rig.

11/9

Rigging up.

11/16

20" - 370' WOC.

11/23

16" - 373' 13" - 525'

Drlg. 540'

11/29

Anhy 740' 10" - 750'

Drlg. 1320'

12/7

Drlg. 2120'

12/14

Tarkio 2300' SO 2430' U.R. 8".

12/21

T.D. 2925' Run 7".

12/28

Lans. 2918' 7" - 2923' S.O.

T.D. 2961' WOC.

1940

1/4

T.D. 3028' 500' oil 2 hours.

OVER

1940
1/10

Lans. 2918'

7" - 2923'

T.D. 3028'

6000 acid.

Potential 1193 bbls. on pump,
plus 10% water.

COMPLETED

1950

O. W. E. D

1/25

OTD 3028' in Lans.

PB to 2300

PD to 2350'

Perf. 2297-2307

500 acid

Pump. 30 BOPD

2/6

NR

FIRST REPORT

COMPLETED

Russell

KANSAS

Map No. _____ Sec. 25 Twp. 14 R. 14W

Well No. 3 B.Rein

Stanolind

Company

Contractor

FIRST REPORT

SECTION PLAT

C $W\frac{1}{2}$ $W\frac{1}{2}$ NW
660 Ft. from N. Line

_____ Ft. from S. Line

_____ Ft. from E. Line

330 Ft. from W. Line

GURNEY POOL

0			

Location X

Rig up

Drilling and Remarks:

RECORD

Cased _____ in., _____ ft.

Sand _____

Gas _____

Oil _____

Total Depth _____

PRODUCTION

1st 24 hrs. Nat. _____

1st 24 hrs. after shot _____

Gas _____ Cu. Ft.

Dry Hole _____

Abandoned _____

Date

OCT 25 1939 19

S. J. LEWIS

Scout

Misc Small Maps

Cards

Tracing

France Map

Scarbrough Map

Moody Map

Geological Dept.

Moody Flat Book

Russell

A-11 SAS

Map No. 72 Sec. 25 Twp. 14 R. 14WWell No. 3 B. ReinStanolind

Company

CORRECTION

Contractor


SECTION PLAT

C W L NW

1320 Ft. from N. Line

_____ Ft. from S. Line

_____ Ft. from E. Line

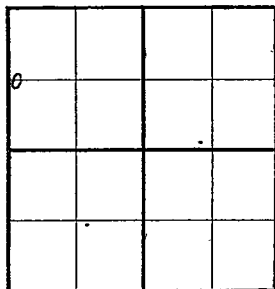330 Ft. from W. Line

GURNEY POOL

Location _____

Rig up _____

Drilling and Remarks:

Reported:

C W L NW NW

RECORD

Cased _____ in., _____ ft.

Sand _____

Gas _____

Oil _____

Total Depth _____

PRODUCTION

1st 24 hrs. Nat. _____

1st 24 hrs. after shot _____

Gas _____ Cu. Ft.

Dry Hole _____

Abandoned _____

Date

NOV 8 1939

19

S. J. LEWIS Scout

Misc Small Maps	_____
Cards	_____
Tracing	_____
France Map	_____
Scarbor Lgh	_____
Moody Map	_____
Cer logical Dept.	_____
Moody Flat Book	_____

Map No. 72 Sec. 25 Twp. 14 R. 14WWell No. 3 B. ReinStanolind

Company

Contractor

COMPLETED**C W L NW**1320 Ft. from N. Line Ft. from S. Line Ft. from E. Line330 Ft. from W. Line**SECTION PLAT**

GURNEY POOLLocation Rig up

Drilling and Remarks:

*Lane 2918.**7" @ 2923**6000 acid**Pump. 1193 BX**plus 10% Water.***RECORD**Cased in., ft.Sand Gas Oil Total Depth 3028**PRODUCTION**1st 24 hrs. Nat. 1st 24 hrs. after shot Gas Cu. Ft.Dry Hole Abandoned

Date

JAN 10 1940₁₉S. J. LEWISScout

Misc. Small Maps

Cards

Tracing

France Map

Scarborough Map

Moody Map

Geological Dept.

Moody Flat Book

O. W. D. D. OWDD

Map No. _____ Sec. 25 Twp. 14 R. 14W

Well No. 3 Ben Rein

Stanolind _____ Company

Contractor _____

C $W\frac{1}{2}$ $W\frac{1}{2}$ NW

El. 1780


SECTION PLAT

1320 Ft. from N. Line

_____ Ft. from S. Line

_____ Ft. from E. Line

330 Ft. from W. Line

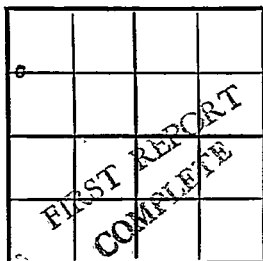

Russell County

Location _____

Rig up _____

Drilling and Remarks:

OTD 3028 in Lans.

PB to 2300

PD to 2350

Perf. 2297-2307

500 acid

Pump 30 bopd

RECORD

Cased _____ in., _____ ft.

Sand _____

Gas _____

Oil _____

Total Depth _____

PRODUCTION

1st 24 hrs. Nat. _____

1st 24 hrs. after shot _____

Gas _____ Cu. Ft.

Dry Hole _____

Abandoned _____

Date

JAN 25 1950 19

J. E. TYRA

Scout

Scout Cards

Land Small Map

Land Wall Map


Laurel

France Map

Pierce Map

Misc.

JAN 30 1953

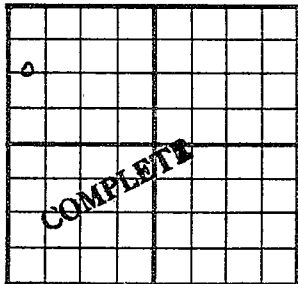County Russell State KansasSec. 25 (Blk. Twp.) 14 (Sur. Rge.) 14W Map No.Operator StanolindWell No. 3 Farm Ben ReinElev. 1780 Location C W L W $\frac{1}{2}$ NW1320 Ft. From N Line NW330 Ft. From W Line Quarter1st. Report 1-25-50Completion 1-25-50Remarks OWDD

Spudding Date _____

Drlg. Data Oil well TD 2350OTD 3028 in Lans. PB to 2300PB to 2350 Perf. 2297-2307 500 AComp. 30 bopd

J. E. TYRA

Scout Cards	
Land Small Map	
Land Wall Map	
racings	
ance Map	
ice Map	
C.	

FEB 18 1952

Orig. Data