

KANSAS


Russell

Form 51-5M-7-40-Palace

Section 25 Township 14 Range 14-W

Well No. #7 Ben Rein

Company Skelly

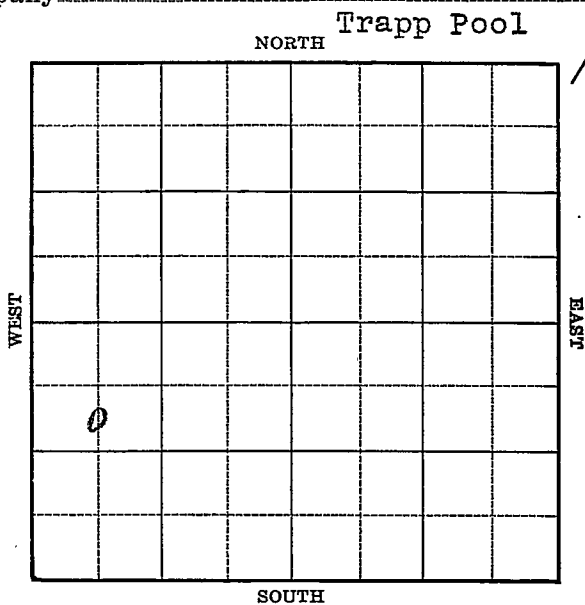

Map No. 72 Sec. 25 Twp. 14 R. 14WWell No. 7 Ben ReinSkelly


Company

FIRST REPORT

Contractor

C S L NW SW

SECTION PLAT

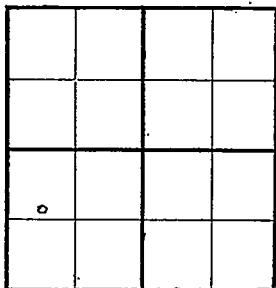990 Ft. from N. Line Ft. from S. Line Ft. from E. Line660 Ft. from W. Line

TRAPP POOL

Location Rig up

Drilling and Remarks:

Drlg. 50'

RECORD

Cased in., ft.Sand Gas Oil Total Depth

PRODUCTION

1st 24 hrs. Nat. 1st 24 hrs. after shot Gas Cu. Ft.Dry Hole Abandoned

Date

OCT 30 1940 19 S. J. LEWIS Scout

Map No. 72 Sec. 25 Twp. 14 R. 14WWell No. 7 Ben ReinSkelly Oil
S

Company

Contractor

COMPLETED
C S L NW SW**SECTION PLAT**990 Ft. from N. Line Ft. from S. Line Ft. from E. Line660 Ft. from W. Line

TRAPP POOL

Location Rig up

Drilling and Remarks:

*Loc. 2900**6" @ 2923**7000 acut**Pump. 1177 P.Y.**39.2 G.S.***RECORD**Cased in., ft.Sand Gas Oil Total Depth 3010**PRODUCTION**1st 24 hrs. Nat. 1st 24 hrs. after shot Gas Cu. Ft..Dry Hole Abandoned

Date

NOV 26 1940 19S. J. LEWIS Scout