


Section 25 Township 14 Range 14W

Well No. #11 Ben Rein

Company Skelly Oil

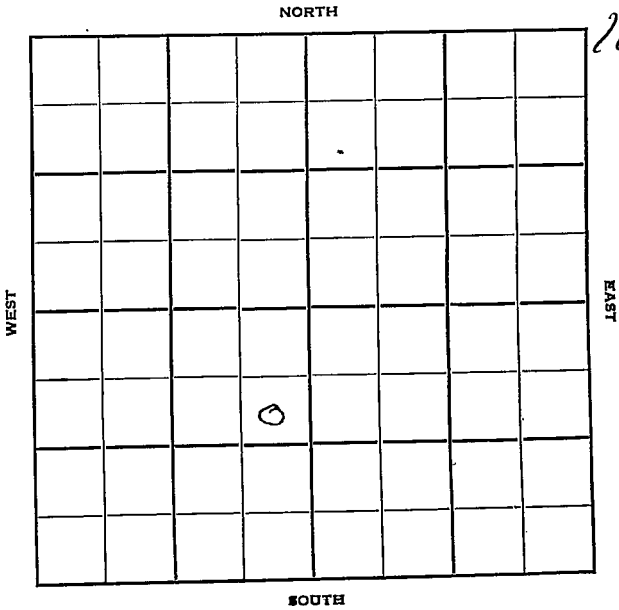

Russell

KANSAS

Sec. 25 Twp. 14 R. 14W

Well No. #11 Ben Rein Farm

Skelly Oil Company

Contractor


990 Ft. from N. Line

Ft. from S. Line

330 Ft. from E. Line

Ft. from W. Line

SW  $\frac{1}{4}$  SE NE SW

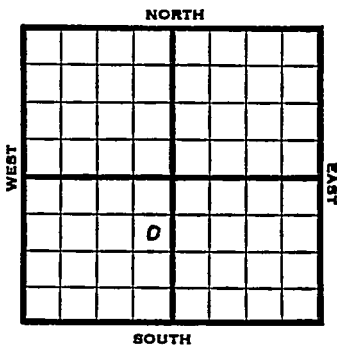

1952

Elev. 1718'

REPORT

11/5 Location

11/12 "

11/20 9" @ 435  
Drlg. 1735'

11/27 NR

12/4 Indian Cave 2260 Tarkio li 2317 RTD  
2399 5" @ 2395 21/2287-94 36/2268-76  
48/2249-58 sd-frac

12/10 Spud 11-11-52  
Oil well TD 2399' 9" @ 435  
Indian cave 2260' Tarkio 2317'  
TD 2399 5" @ 2395 21/2287-94  
36/2268-76 48/2249-58 sd-frac.  
P/17 BO 1 BW 4 hr.  
Comp. 102 BOPD 6 BW

**COMPLETED**



County Russell State Kansas

Sec. 25 (Blk. Twp.) 14 (Sur. Rge.) 14W Map No.

Operator Skelly Oil

Well No. 11 Farm Ben Rein

Elev. 1748 Location SE NE SW


COMPLETE

990 Ft. From N Line SW

330 Ft. From E Line Quarter

Ist. Report

Completion DEC 10 1952

Remarks

Spudding Date 11-11-52

Drilg. Data Oil well TD 2399

9" @ 435 Indian cave 2260 Tarkio 2317

TD 2399 5" @ 2395 21/ 2287-94

36/ 2268-76 48/ 2249-58 sd-frac

P/ 17 b0 1 bw 4hr.

Comp. 102 bopd 6 bw