
FORM 51-25M 8-50 WESTERN Russell KANSAS

Section 25 Township 11 Range 11W

Well No. #9 Hickey

Company Cities Service Oil

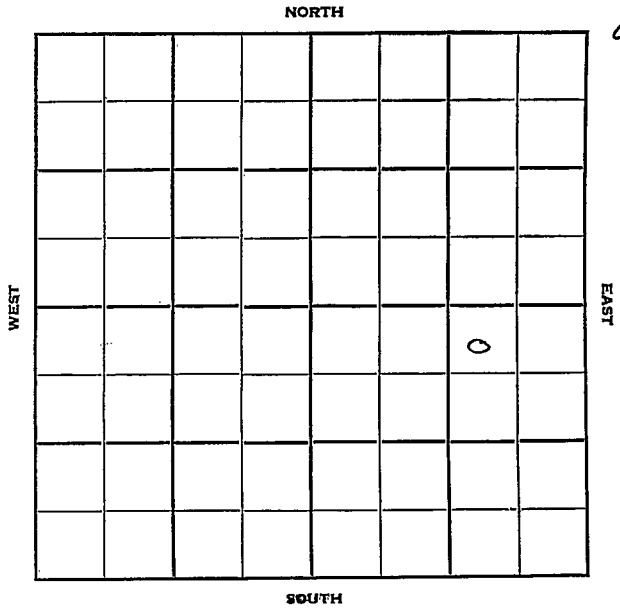

FORM 252-B
10M 8-51 TPCO. Russell

KANSAS ✓

Sec. 25 Twp. 14 R. 14W

Well No. #9 Hickey Farm

Cities Service Oil Company

Lohman & Johnson Contractor


330 Ft. from N. Line

Ft. from S. Line

990 Ft. from E. Line

Ft. from W. Line

NW NE SE

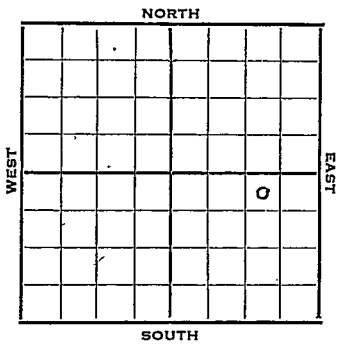


| 1952 | Elev. 1750' REPORT |
|---|---|
| 8/20 | Spud 8-16-52<br>8" @ 242'<br>Drlg. 1740' |
| 8/27 | Tarkio 2256 RTD 2391<br>5" @2391 |
| 9/4 | Spud 8-16-52<br>Oil Well TD 2391' 8" @ 242<br>Tarkio 2256' TD 2391'<br>5" @ 2391' CO to 2368<br>105/ 2268-83 Sd-Frac<br>Comp. 237 bopd |

**COMPLETED**

FORM 275 FOR SALE BY KANSAS BLUE PRINT CO.


County Russell State Kansas

Sec. 25 (Blk.) (Twp.) 14 (Sur.) (Rge.) 14W Map No.

Operator Cities Service Oil

Well No. 9 Farm Hickey

Elev. Location NW NE SE

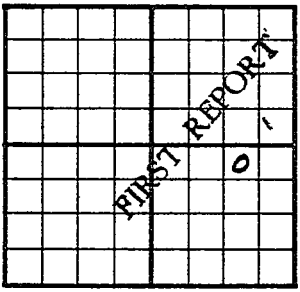


330 Ft. From N Line SE

990 Ft. From E Line Quarter

1st. Report AUG 20 1952

Completion

Remarks

Lohman & Johnson - Contr.

Spudding Date 8-16-52

Drlg. Data

8" @ 242 Drlg. 1740

J. G. McGEHEE

FORM 275 FOR SALE BY KANSAS BLUE PRINT CO.


County Russell State Kansas

Sec. 25 (Blk. Twp.) 14 (Sur. Rge.) 14W Map No.

Operator Cities Service Oil

Well No. 9 Farm Hickey

Elev. 1750 Location NW NE SE

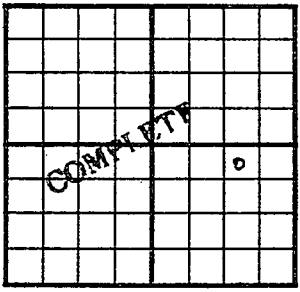


330 Ft. From N Line SE

990 Ft. From E Line Quarter

1st. Report

Completion SEP 4 1952

Remarks

Lohman & Johnson - Cntr

Spudding Date 8-16-52

Drlg. Data Oil well TD 2391

8" @ 242 Tarkio 2256 TD 2391

5" @ 2391 CO to 2368. 105/ 2268-83

Sd.-frac Comp. 237 bopd

J. G. McGEHEE