

Section 25 Township 14 Range 14W

Well No. #14 Hickey

Company Cities Service Oil

NORTH

16

WEST

EAST

SOUTH.

Russell

KANSAS



Sec. 25 Twp. 14 R. 14 W

Well No. # 14 Hickey Farm

Cities Service Oil Company

Contractor


 Ft. from N. Line

330 Ft. from S. Line

940 Ft. from E. Line

 Ft. from W. Line

SW SE SE

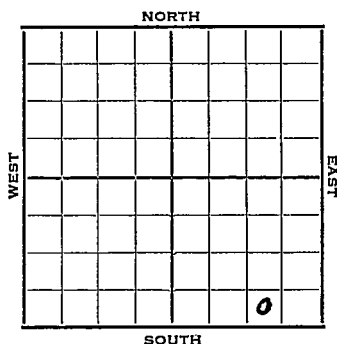

1952

Elev. 1734' REPORT

9/24

Location

10/2

8" @ 202 1st Tarkio 2241'
2nd Tarkio 2253' RTD 2400'
~~XXX~~ 4" @ 2400

10-8

CO to 2370
117/2250-72, 26/2274-78
Sd-frac

10/15

F 8 BO 13 BWPD, sq off

10/22

CO 2369' 102/2316-37 sd-frac
sq off

10/29

CO 2298' 98/2254-71 Sd-frac.

11/5

NR

11/12

"

11/19

Spud 9-22-52 Oil well TD 2400'
8" @ 202 1st Tarkio 2241' 2nd
Tarkio 2253' TD 2400' 4" @ 2400
CO to 2370' 117/2250-72 26/2274-78
Sd-frac. F/8 BO 13 BWPD CO to 2369
102/2316-37 Sd-frac. CO to 2298'
98/2254-71 Sd-frac. P & F/26 BOPD
475,000 gas Comp.

COMPLETED

J. G. McGEHEE

J. G. MCGEEHEE

J. G. McGEHEE