

# KANSAS


Form 51-5M-7-40-Palace

Russell

Section 25 Township 14 Range 14-W

Well No. #5 Rein

Company Skelly Oil

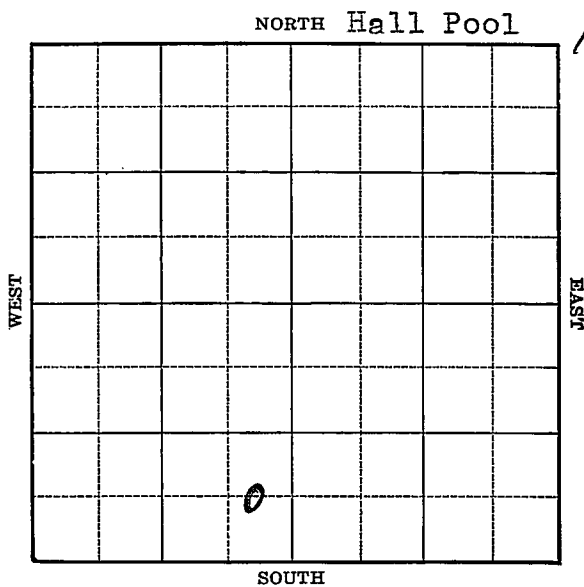

KANSAS

Russell

Sec. 25 Twp. 14 R. 14-WWell No. #5 Rein Farm \_\_\_\_\_Skelly Oil


Company \_\_\_\_\_

(Hall)

\_\_\_\_\_ Ft. from N. Line

660 Ft. from S. Line330 Ft. from E. Line

\_\_\_\_\_ Ft. from W. Line

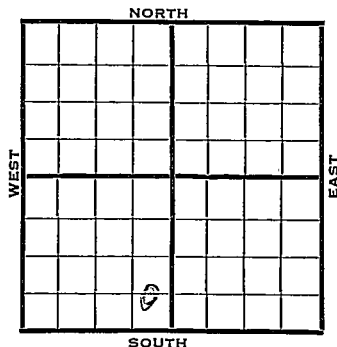Elev. 1734

1940

## REPORT

8/14

Derrick.

8/22

10" - 306' Drlg. 1020'

8/29

Drlg. 2580'

9/5

Lans. 2863' Pay 2888-90' T.D.

6" - 2888' RUST.

9/12

T.D. 2980' S.O. Run tubing.

9/18

Lans. 2865'

6" - 2890'

T.D. 2980'

7000 acid.

Potential 1441 bbls., pump.

COMPLETED

Map No. \_\_\_\_\_ Sec. 25 Twp. 14 R. 14WWell No. 5 ReinSkelly Oil Company

Contractor \_\_\_\_\_

C E L SE SW

\_\_\_\_\_ Ft. from N. Line

660 Ft. from S. Line330 Ft. from E. Line

\_\_\_\_\_ Ft. from W. Line

## SECTION PLAT

|  |  |  |  |
|--|--|--|--|
|  |  |  |  |
|  |  |  |  |
|  |  |  |  |
|  |  |  |  |

HALL POOL

Location \_\_\_\_\_

Rig up \_\_\_\_\_

Drilling and Remarks:

**Derrick**

## RECORD

Cased \_\_\_\_\_ in., \_\_\_\_\_ ft.

Sand \_\_\_\_\_

Gas \_\_\_\_\_

Oil \_\_\_\_\_

Total Depth \_\_\_\_\_

## PRODUCTION

1st 24 hrs. Nat. \_\_\_\_\_

1st 24 hrs. after shot \_\_\_\_\_

Gas \_\_\_\_\_ Cu. Ft.

Dry Hole \_\_\_\_\_

Abandoned \_\_\_\_\_

Date

AUG 1 ± 1940 19S. J. LEWIS Scout

new maps  
Paul

|                  |      |
|------------------|------|
| Misc Small Maps  | Paul |
| Cards            | Paul |
| Tracing          | Jim  |
| France Map       | Jim  |
| Scarborough Map  | Jim  |
| Moody Map        | Jim  |
| Geological Dept. |      |
| Moody Flat Book  |      |

Map No. 72 Sec. 25 Twp. 14 R. 14WWell No. 5 ReinSkelly Oil

Company

Contractor

**COMPLETED****C E L S E S W**

\_\_\_\_\_ Ft. from N. Line

660 Ft. from S. Line330 Ft. from E. Line

\_\_\_\_\_ Ft. from W. Line

**HALL POOL****SECTION PLAT**

|  |  |  |  |
|--|--|--|--|
|  |  |  |  |
|  |  |  |  |
|  |  |  |  |
|  |  |  |  |

Location \_\_\_\_\_

Rig up \_\_\_\_\_

Drilling and Remarks:

*Loss 2865.**6" 2890**7000 Acid**Pump. 1441 P.S.***RECORD**

Cased \_\_\_\_\_ in., \_\_\_\_\_ ft.

Sand \_\_\_\_\_

Gas \_\_\_\_\_

Oil \_\_\_\_\_

Total Depth 2980**PRODUCTION**

1st 24 hrs. Nat. \_\_\_\_\_

1st 24 hrs. after shot \_\_\_\_\_

Gas \_\_\_\_\_ Cu. Ft.

Dry Hole \_\_\_\_\_

Abandoned \_\_\_\_\_

Date

SEP 18 1940 19S. J. LEWIS Scout

|                  |      |
|------------------|------|
| Misc. Small Maps | Done |
| Cards            | Done |
| Tracing          | Done |
| France Map       | Done |
| Scarborough Map  | Done |
| Moody Map        | Done |
| Geological Dept. |      |
| Moody Flat Book  |      |