


Section 25 Township 14 Range 14 W

Well No. # 10 Rein

Company Skelly Oil

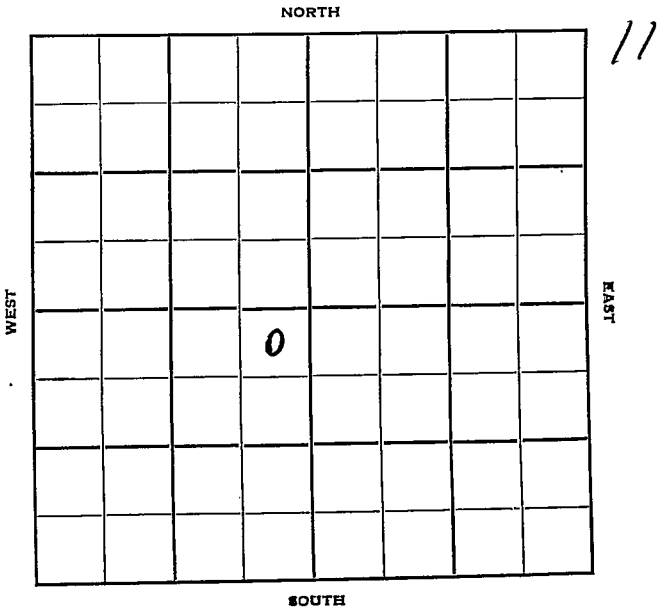

Russell

KANSAS ✓

Sec. 25 Twp. 14 R. 14W

Well No. #10 Rein Farm _____

Skelly Oil Company _____

Contractor _____

330 **Hall-Gurney Pool**


NORTH

Ft. from N. Line

Ft. from S. Line

330 Ft. from E. Line

Ft. from W. Line

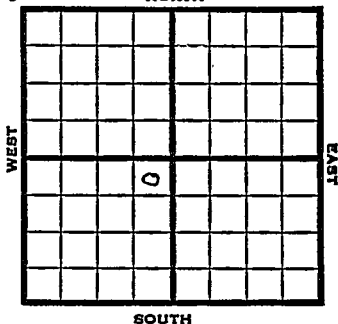

NE NE SW

1952 Elev. 1745' REPORT

10/8 Location

10/15 8" @ 276
Drlg. 1825'

10/22 Indian Cave Sd 2259'
TD 2400
7" @ 2398'

10/29 NR

11/5 Spud 10-7-52
Oil Well TD 2400' 8" @ 276
Indian cave sd 2259
TD 2400 7" @ 2398 70/ 2270-80
35/ 2255-60 Sd-Frac
Comp. 86 bopd 37 bw

COMPLETED

