


Russell

Map No. KANSAS Sec. 25 Twp. 14 R. 15W

Well No. 3- Harbaugh Farm
Hartman & Blair Company

992
350 Ft. from N. Line
Ft. from S. Line
330 Ft. from E. Line
Ft. from W. Line
Elev. 1741

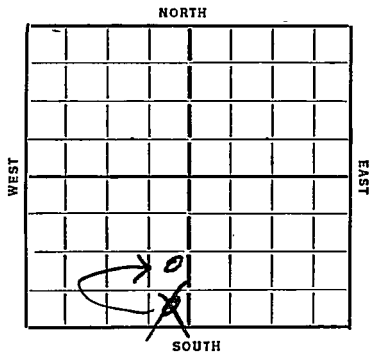

REPORT **O. W. D. D**

1926 1936	
3/18	Location
3/20	--
3/27	Cellar.
4/2	--4/10--4/16--4/23--4/30--5/7--
5/14	--5/21--5/28--6/4--6/11-- 6/18
6/25	--7/2--7/9--
7/16	B. Rig.
7/23	--Rigging up.
7/30	Shut down.
8/6	10" @ 755'. Drlg. 765'.
8/13	Drlg. 1865'.
8/20	8 1/2" @ 2320'. Drlg. 2375'.
8/27	Topeka 2666'. Drlg. 2855'.
9/3	2912' shut down.
9/23	/36-Gorham 3145'. T.D. 3152'. Potential 1307 bbls of oil.
	OVER COMPLETED OVER

1936

O. W. D. D

~~10/21~~ ~~old total depth 3150'~~
~~cleaning out.~~

~~10/29~~ ~~DRILL~~ ~~3166'~~

Map No. 72 Sec. 25 Twp. 14 R. 15N

Well No. 3 - Harbaugh
Hartman + Blair Company

Contractor

FIRST REPORT

SECTION PLAT

.....Ft. from N. Line

330 Ft. from S. Line

330 Ft. from E. Line

.....Ft. from W. Line

Location

Rig up

Drilling and Remarks:

RECORD

Cased.....in.,ft.

Sand.....

Gas.....

Oil.....

Total Depth.....

PRODUCTION

1st 24 hrs. Nat.....

1st 24 hrs. after shot.....

Gas.....Cu. Ft.

Dry Hole.....

Abandoned.....

Date

3-18-36 192.....

ORVAL MANNSCHRECK

Scout

KANSAS

Map No. 72 Sec. 25 Twp. 14 R. 15WWell No. 3 HartmanHartman & Blair Company

Contractor

SECTION PLAT

_____ Ft. from N. Line

990 Ft. from S. Line330 Ft. from E. Line

_____ Ft. from W. Line

CORRECTION

Location _____

Rig up _____

Drilling and Remarks:

Reported
BESSA.

RECORD

Cased _____ in., _____ ft.

Sand _____

Gas _____

Oil _____

Total Depth _____

PRODUCTION

1st 24 hrs. Nat. _____

1st 24 hrs. after shot _____

Gas _____ Cu. Ft.

Dry Hole _____

Abandoned _____

Date

JUL 8 1936₁₉S. J. LEWIS

Scout

KANSAS

Form 26—1M Bks.—2-29

Russell

Map No. 72 Sec. 25 Twp. 14 R. 15W.

Well No. 3 Hartough

Hartman & Blair Company

Contractor

SECTION PLAT

_____ Ft. from N. Line

990 Ft. from S. Line

230 Ft. from E. Line

_____ Ft. from W. Line

COMPLETED

Location _____

Rig up _____

Drilling and Remarks:

Got down 3145

Per 1307

RECORD

Cased _____ in., _____ ft.

Sand _____

Gas _____

Oil _____

Total Depth 3152

PRODUCTION

1st 24 hrs. Nat. _____

1st 24 hrs. after shot _____

Gas _____ Cu. Ft.

Dry Hole _____

Abandoned _____

Date

SEP 23 1936 19

S. I. LEWIS Scout

KANSAS

Form 26 1M Bks. 2-29

Map No. 72 Sec. 25 Twp. 14 R. 15W

Well No. 3 Hartman & Blair

Hartman & Blair Company

Contractor

SECTION PLAT

	0		

_____ Ft. from N. Line

990 Ft. from S. Line

330 Ft. from E. Line

_____ Ft. from W. Line

FIRST REPORT

OW 117

O. W. D. RECORD

Location _____

Rig up _____

Drilling and Remarks:

Old 117 3150

CO

Cased _____ in., _____ ft.

Sand _____

Gas _____

Oil _____

Total Depth _____

PRODUCTION

1st 24 hrs. Nat. _____

1st 24 hrs. after shot _____

Gas _____ Cu. Ft.

Dry Hole _____

Abandoned _____

Date

OCT 21 1936
19

S. J. LEWIS

Scout