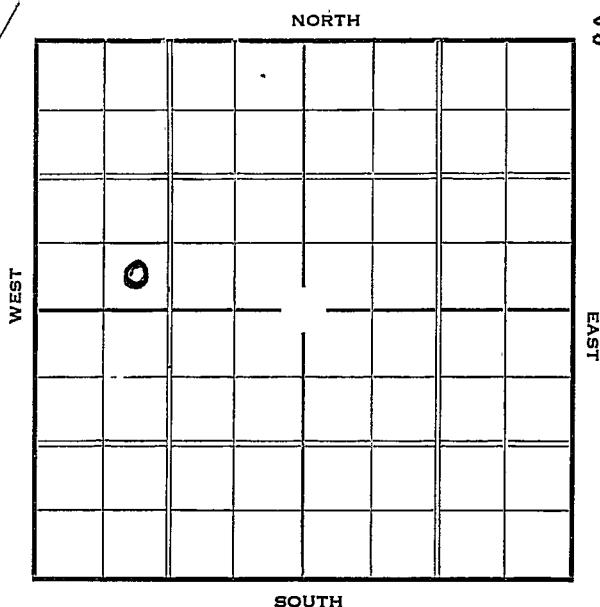



Section 25 Township 14 Range 15-WWell Number 5 - HarbaughCompany Ohio

Sec. 25 Twp. 14 R. 15-WWell No. #5 Harbaugh FarmOhio

Company

 Ft. from N. Line330 Ft. from S. Line Ft. from E. Line990 Ft. from W. Line

Elev. 1747

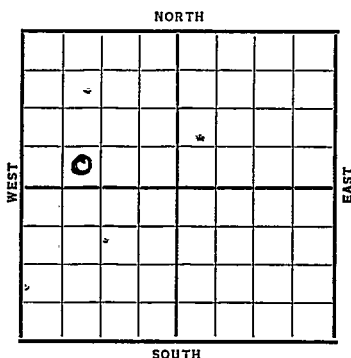

Date	REPORT
1937	
5/5	Location
5/14	Rig'n up cable.
5/21	Rig
5/28	20" @ 115'. Drlg. 125'.
6/4	15" @ 272'. Drlg. 520'.
6/11	12" @ 768'. Anhy 755'.
	Drlg. 785'.
6/19	SD 1695'.
6/25	Drlg. 2130'.
7/2	10" @ 2269'. T.D. 2460' Fsg.
7/9	10" @ 2373'. T.D. 2475'. C.O.
7/16	10" @ 2434'. Drlg. 2865'.
7/23	Oswald 2890'. Sil. 3157'.
	T.D. 3161'. 6" @ 3157'.
	H.F.O.
7/30	" " "
	OVER

1937

8/4 6" @ 3157'.

Sil. 3157'.

T.D. 3161'.

1000 acid.

Pot. 1456 bbls.

COMPLETED

Russell KANSAS

Map No. 72 Sec. 25 Twp. 14 R. 15 WWell No. 5 - Harbaugh
Ohio Company

Contractor

FIRST REPORT

SECTION PLAT

_____ Ft. from N. Line

330 Ft. from S. Line

_____ Ft. from E. Line

990 Ft. from W. Line

0			

Location ✓

Rig up _____

Drilling and Remarks:

RECORD

Cased _____ in., _____ ft.

Sand _____

Gas _____

Oil _____

Total Depth _____

PRODUCTION

1st 24 hrs. Nat. _____

1st 24 hrs. after shot _____

Gas _____ Cu. Ft.

• Dry Hole _____

Abandoned _____

Date

MAY 5 - 1967

19

H. D. Hatfield Scout

KANSAS

Russell

Map No. 72 Sec. 25 Twp. 14 R. 15-WWell No. 5-Harbaugh
Ohio Company

Contractor

COMPLETED**SECTION PLAT**

0			

_____ Ft. from N. Line

530 Ft. from S. Line

_____ Ft. from E. Line

990 Ft. from W. Line

Location _____

Rig up _____

Drilling and Remarks:

1000 acidPat- 1456**RECORD**Cased 6 in., 3157 ft.Sand 511 3157

Gas _____

Oil _____

Total Depth 3161**PRODUCTION**

1st 24 hrs. Nat. _____

1st 24 hrs. after shot _____

Gas _____ Cu. Ft.

Dry Hole _____

Abandoned _____

Date

AUG 4 - 1937 19 _____ H. D. Hatfield Scout