

Russell KANSAS

Section 25 Township 14 Range 15-W

Well Number 5 Harbaugh


Company Hartman & Blair

NORTH

WEST


EAST

SOUTH

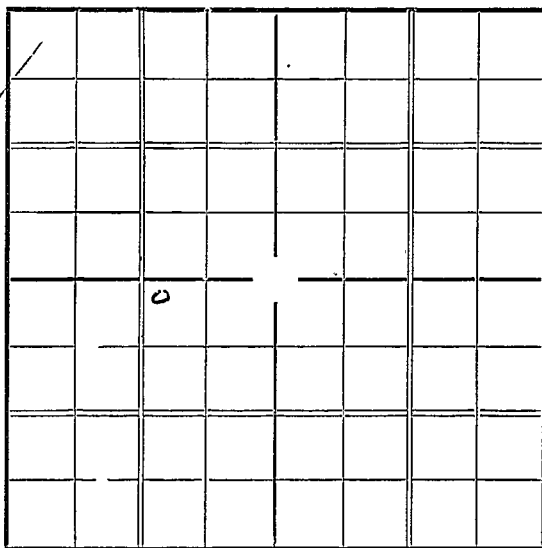

KANSAS

Russell

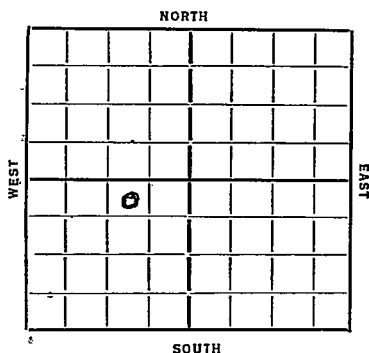Map No. _____ Sec. 25 Twp. 14 R. 15-WWell No. #5 Harbaugh Farm _____Hartman & Blair Company _____330 Ft. from N. Line Ft. from S. Line990 Ft. from E. Line Ft. from W. Line

Date	REPORT
1936	
12/29	Location
1937	
1/7	Rig.
1/14	"
1/21	"
1/28	"
2/4	"
2/11	"
2/19	"
2/26	"
3/4	"
3/11	"
3/18	"
3/25	"
4/2	"
4/8	"
4/16	"
4/23	"
4/30	"
5/7	"
5/21	Spud
5/28	12" @ 465'. WOC.

OVER

KANSAS

Map No. _____ Sec. 25 Twp. 14 R. 15WWell No. 5 HartmanHartman & Blair Company

Contractor _____

SECTION PLAT

	0		

380 Ft. from N. Line

_____ Ft. from S. Line

990 Ft. from E. Line

_____ Ft. from W. Line

FIRST REPORT

Location ✓

Rig up _____

Drilling and Remarks:

RECORD

Cased _____ in., _____ ft.

Sand _____

Gas _____

Oil _____

Total Depth _____

PRODUCTION

1st 24 hrs. Nat. _____

1st 24 hrs. after shot _____

Gas _____ Cu. Ft.

Dry Hole _____

Abandoned _____

Date

DEC 29 1936S. J. LEWIS

Scout

Russell KANSAS

Map No. _____ Sec. 25 Twp. 14 R. 15^WWell No. 5-HarbaughHartman & Blair Company

Contractor _____

COMPLETED

SECTION PLAT

	0		

330 Ft. from N. Line

_____ Ft. from S. Line

990 Ft. from E. Line

_____ Ft. from W. Line

Location _____

Rig up _____

Drilling and Remarks:

Pat 1312
net

RECORD

Cased 6 in., 3149 ft.Sand Gorham 3148

Gas _____

Oil _____

Total Depth 3158

PRODUCTION

1st 24 hrs. Nat. _____

1st 24 hrs. after shot _____

Gas _____ Cu. Ft.

Dry Hole _____

Abandoned _____

Date

JUL 7 1937 19H. D. Fairfield Scout

1937

6/4 15" @ 280'. Anhy 753'.
10" @ 760'. Drlg. 1008'.

6/11 Drlg. 2420'.

6/19 8" @ 2497'. Drlg. 2655'.

6/25 8" @ 2644'. Osw. 2910'.
Drlg. 3110'. 1½ bailers oil
3051-62'.

7/2 Gorham 3148'. 6" @ 3149'.
T.D. 3158'. H.F.O.

7/7 6" @ 3149'.
Gorham 3148'.
T.D. 3158'.
Pot. 1312 bbls. Nat.

COMPLETED