


Section 25 Township 14 Range 15-W

Well No. 6 - Harbaugh

Company Ohio

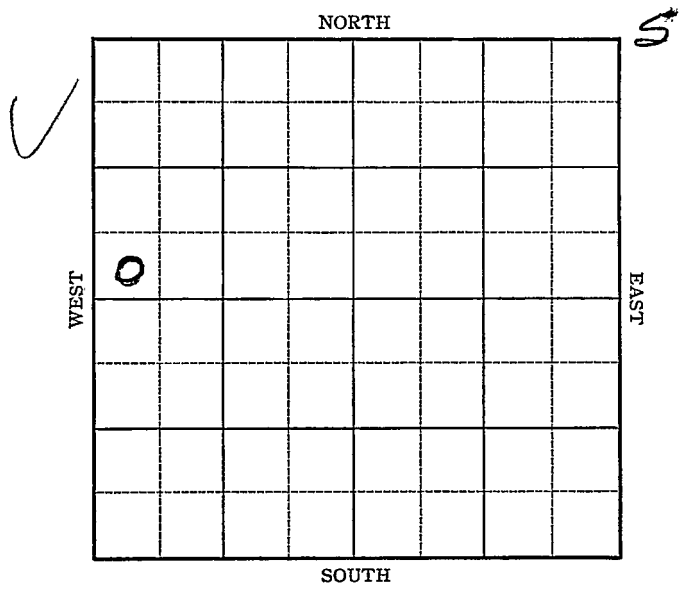

Sec. 25 Twp. 14 R. 15-WWell No. #6 Harbaugh FarmOhio Company


_____ Ft. from N. Line

330 Ft. from S. Line

_____ Ft. from E. Line

330 Ft. from W. Line

Elev. 1749

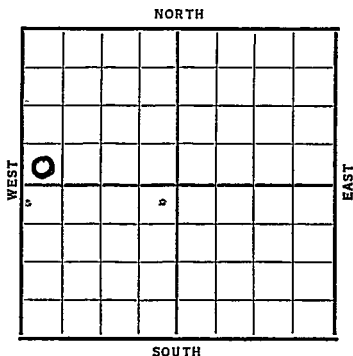

Date

REPORT

1937

8/4 Location

8/13 B. R.

8/20 R. U.

8/28 Spud.

9/3 20" @ 99'. 15" @ 263'.

Anhy 756'. 12" @ 775'. WOC.

9/10 Drlg. 1785'.

9/17 Drlg. 2285'.

9/24 10" @ 2384'. Drlg. 2890'.

10/2 K.C. & 8" @ 2925'.

S.O. 2990-95'. Drlg. 3140'.

10/8 SD 3171'.

10/15 6" @ ~~3169~~ 3169'.

Gorham 3167'. T.D. 3174'.

3000' oil. 1000 acid.

OVER

Russell KANSASMap No. _____ Sec. 25 Twp. 14 R. 15 WWell No. 6 - Harbaugh
Ohio Company

Contractor

FIRST REPORT

SECTION PLAT

_____ Ft. from N. Line

330 Ft. from S. Line

_____ Ft. from E. Line

330 Ft. from W. Line

0			

Location ✓

Rig up _____

Drilling and Remarks:

RECORD

Cased _____ in., _____ ft.

Sand _____

Gas _____

Oil _____

Total Depth _____

PRODUCTION

1st 24 hrs. Nat. _____

1st 24 hrs. after shot _____

Gas _____ Cu. Ft.

Dry Hole _____

Abandoned _____

Date

AUG 4 - 1937 19H. D. Hatfield Scout

Russell KANSAS

Map No. _____ Sec. 25 Twp. 14 R. 15WWell No. 6 Harbaugh1 Ohio Company

Contractor

COMPLETED

SW NW

SECTION PLAT

_____ Ft. from N. Line

330 Ft. from S. Line

_____ Ft. from E. Line

330 Ft. from W. Line

0			

Location _____

Rig up _____

Drilling and Remarks:

1000 AcidPOT-979**RECORD**Cased 6 in., 3165 ft.Sand Garham 3167

Gas _____

Oil _____

Total Depth 3174**PRODUCTION**

1st 24 hrs. Nat. _____

1st 24 hrs. after shot _____

Gas _____ Cu. Ft.

Dry Hole _____

Abandoned _____

Date

OCT 20 1937 19H. D. Hatfield Scout

1937

10/20 6" @ 3165'.

Gorham 3167'.

T.D. 3174'.

1000 acid.

Potential 979 bbls.

COMPLETED