
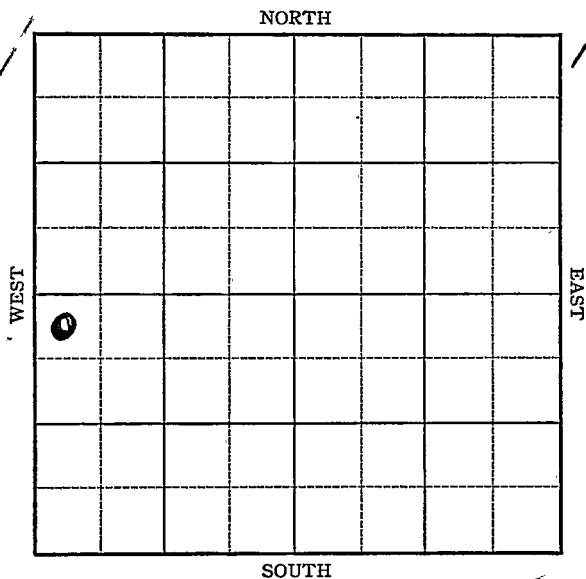


Section 25 Township 14 Range 15WWell No. #8 ~~7~~ HarboughCompany Hartman & Blair

Sec. 25 Twp. 14 R. 15 -WWell No. #7 Harbaugh #8 FarmHartman & Blair Company330 Ft. from N. Line Ft. from S. Line Ft. from E. Line330 Ft. from W. Line

Elev. 1747

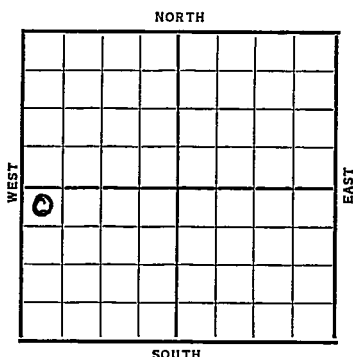

Date	REPORT
1937	
7/28	Location
8/6	"
8/13	Cellar
8/20	R. U.
8/28	"
9/3	"
9/10	15" @ 150'. 12" @ 440'.
	Drlg. 665'.
9/17	Anhy 767'. 10" @ 770'.
	Drlg. 1000'.
9/24	Drlg. 2075'.
10/2	T.D. 2410'. U.R. 8".
10/8	8" @ 2510'. Drlg. 2685'.
10/15	S.O. 2970-75' & 3040-45'.
	6" @ 3182'. C.O.
10/22	Correction: 3182 equals 3162'.
	Pay 3165-83' T.D. 2600' oil
	6 hrs.
10/29	1000 acid.
	OVER

1937

11/3 6" @ 3155'.

Gorham 3155'.

T.D. 3162'.

Hole was off 8 degrees.

1000 acid.

Potential 1351 bbls.

COMPLETED

KANSAS

Russell

Map No. _____ Sec. 25 Twp. 14 R. 15^WWell No. 7-HarbaughHartman & Blair Company

Contractor _____

FIRST REPORT

SECTION PLAT

330 Ft. from N. Line Ft. from S. Line Ft. from E. Line330 Ft. from W. Line

0			

Location ✓

Rig up _____

Drilling and Remarks:

RECORD

Cased _____ in., _____ ft.

Sand _____

Gas _____

Oil _____

Total Depth _____

PRODUCTION

1st 24 hrs. Nat. _____

1st 24 hrs. after shot _____

Gas _____ Cu. Ft.

Dry Hole _____

Abandoned _____

Date

JUL 28 1931

H. D. Hatfield

Scout

Russell KANSAS

Map No. _____ Sec. 25 Twp. 14 R. 15^WWell No. 8-Harbaugh
Hartman & Blair Company

Contractor _____

CORRECTION

330 Ft. from N. Line

_____ Ft. from S. Line

_____ Ft. from E. Line

330 Ft. from W. Line

SECTION PLAT

0			

Location _____

Rig up _____

Drilling and Remarks:

*This was originally
given out as #7*

*operators have switched
numbers on locations of 7 & 8*

RECORD

Cased _____ in., _____ ft.

Sand _____

Gas _____

Oil _____

Total Depth _____

PRODUCTION

1st 24 hrs. Nat. _____

1st 24 hrs. after shot _____

Gas _____ Cu. Ft.

Dry Hole _____

Abandoned _____

Date

AUG 25 1937

19

H. D. Hatfield

Scout

Russell

KANSAS

Map No. _____ Sec. 25 Twp. 14 R15W

Well No. 8 Harbaugh

Hartman & Blair

Company

Contractor

COMPLETED

NW SW

330 Ft. from N. Line

_____ Ft. from S. Line

_____ Ft. from E. Line

330 Ft. from W. Line

SECTION PLAT

0			

Location _____

Rig up _____

Drilling and Remarks:

Hole was off 8 degrees

1000 Acid

PT- 1351

RECORD

Cased 6 in., 3155 ft.

Sand Gorham 3155

Gas _____

Total Depth 3162

PRODUCTION

1st 24 hrs. Nat. _____

1st 24 hrs. after shot _____

Gas _____ Cu. Ft.

Dry Hole _____

Abandoned _____

Date

NOV 3 1937 19

H. D. Hatfield Scout