FORM 51 10M 2-49 PETROL

KANSAS


Russell

Section 25 Township 14 Range 15W

Well No. 9 Harbough

Company Ohio

Gorham

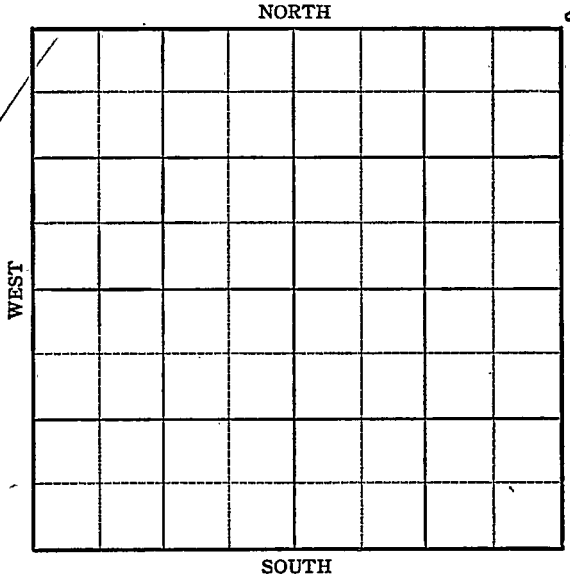

FORM 252-A
5M 10-48 PETROL

KANSAS

Sec. 25 Twp. 14 R. 15W

Russell

Well No. #9 Harbough Farm

Ohio Company

Gorham Pool


990' Ft. from N. Line

Ft. from S. Line

990' Ft. from E. Line

Ft. from W. Line

SW NE NW

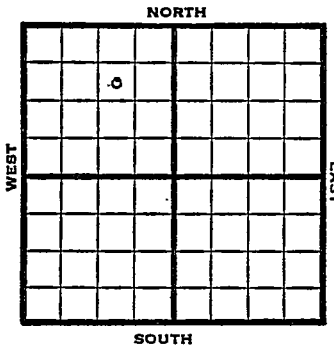

1949	1763' Elev ~~1760'~~	REPORT
2/23	Location	
3/2	"	
3/8	"	
3/16	8"@ 817'	
3/23	Drlg. 2350'	
3/30	No Report	
4/6	Lansing 2923' Gorham 3162-67' TD 3167 5"@ 3163' 2500 oil 12 hrs.	
4/12	TD 3169'	
4/20	TD 3169' Gorham 3162' 5"@ 3163' Pump 50 Oil Pot 37° Gr. Comp COMPLETED	

Form 26 200 Bks. 9-48 Petrol

Kansas

Gorham Pool

Map No. _____ Sec. 25 Twp. 14 R. 15W

Well No. 9 Harbough

Ohio Company

FIRST REPORT Contractor

SW NE NW


990 Ft. from N. Line

_____ Ft. from S. Line

990 Ft. from E. Line

_____ Ft. from W. Line

SECTION PLAT

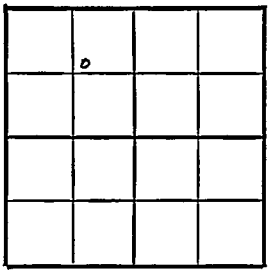

Russell County

Location X

Rig up

Drilling and Remarks:

RECORD

Cased _____ in., _____ ft.

Sand

Gas

Oil

Total Depth

PRODUCTION

1st 24 hrs. Nat.

1st 24 hrs. after shot

Gas _____ Cu. Ft.

Dry Hole

Abandoned

Date

FEB 23 1949 19

S. J. LEWIS Scout

Form 26 200 Bks. 9-48 Petrol

Kansas

Gorham Pool

Map No. K-72 Sec. 25 Twp. 14 R. 15W

Well No. 9 Harbough

Ohio Company

COMPLETE

Contractor

SW NE NW

990 Ft. from N. Line

Ft. from S. Line


990 Ft. from E. Line

Ft. from W. Line

Russell County

E. 1763

SECTION PLAT

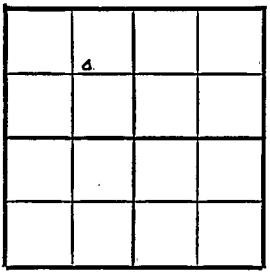

Location

Rig up

Drilling and Remarks:

Gorham 3162

5" @ 3163

Pump 50 bbl/Hr

87° Gr

RECORD

Cased in., ft.

Sand

Gas

Oil

Total Depth 3169

PRODUCTION

1st 24 hrs. Nat.

1st 24 hrs. after shot

Gas Cu. Ft.

Dry Hole

Abandoned

Date

APR 20 1949 19

S. J. LEWIS Scout