

Section 25 Township 14 Range 15W


Well No. 10 Harbough

Big Creek Pool

Company Harry Gore

NORTH

12

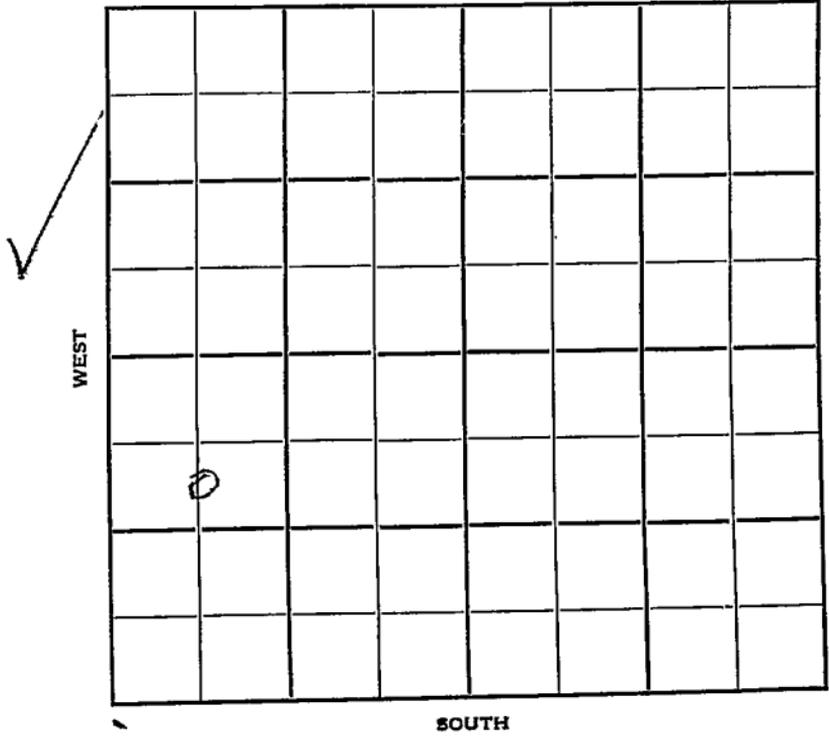

SOUTH

✓


Sec. 25 Twp. 14 R. 15W ✓

Well No. #10 Harbough Farm

Harry Gore

Big Creek Pool (Harry Gore, Cont.) Company

NORTH

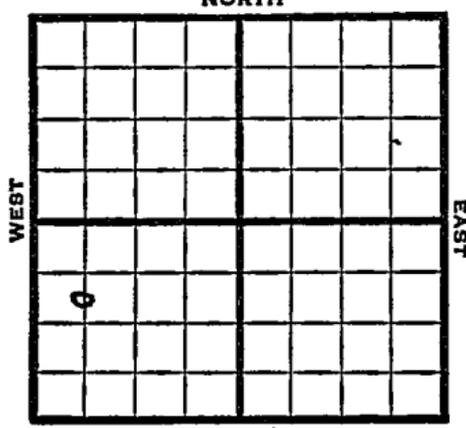

SOUTH

990' Ft. from N. Line

_____ Ft. from S. Line

_____ Ft. from E. Line

660' Ft. from W. Line

C S L NW SW

1949

^Elev 1768' REPORT

- 6/8 Drlg. 130'
- 6/15 10" @ 805'
- 6/21 Drlg 1200'
- 6/28 fsg.
- 7/6 "
- 7/12 Drlg 1575'
- 7/20 Drlg 2170'
- 7/27 8" @ 2405'
- Drlg 2445'
- 8/3 "
- 8/10 Lansing 2949
- TD 3183'
- 7" @ 3183'
- 8/17 "
- 8/24 TD 3189'
- Lansing 2949'
- 7" @ 3183'
- Pump 100 Oil Pot
- 36° Gr.
- Comp

COMPLETED

Russell County Kansas State

Map No. _____ Sec. 25 Twp. 14 R. 15W

Well No. 10 Harbough

Harry Gore Company

Harry Gore Contractor

**FIRST REPORT
SECTION PLAT**

C S L NW SW

990 Ft. from N. Line

_____ Ft. from S. Line

_____ Ft. from E. Line

660 Ft. from W. Line

Big Creek Pool

Remarks:

drlg. 130

Date JUN 8 1949

Scout S. J. LEWIS

