


Well Number #3 Harbaugh

Company Ohio Oil

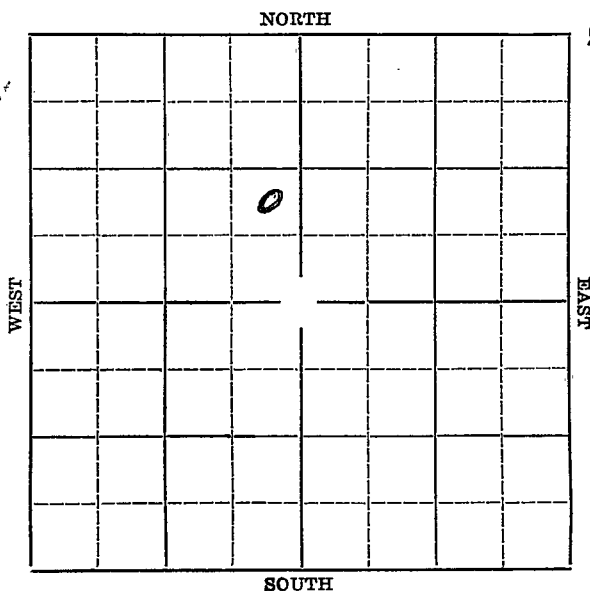


Sec. 25 Twp. 14 R. 15WWell No. #3 Harbough FarmOhio Oil Co. Company

Ft. from N. Line

990' Ft. from S. Line330' Ft. from E. Line

Ft. from W. Line

Elev. 1738

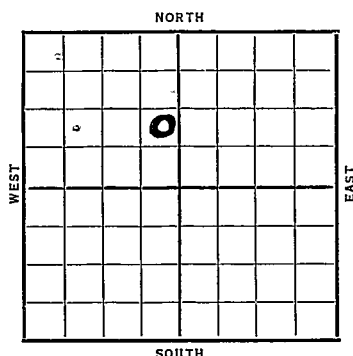

Date	REPORT
1936	
10/21	Location.
10/29	Rig on ground.
11/6	Rig
11/12	Spud
11/19	15" @ 259'. Drlg. 445'.
11/27	Drlg. 765'.
12/3	Anhydrate 760'. 12" @ 763'.
	Drlg. 1550'.
12/10	2290' fishing.
12/17	10" @ 2380'. Drlg. 2580'.
12/24	Oswald 2900' Set 8". Drlg. 2931'
	400' oil in hole.
12/29	2947' under ream 8".
1937	
1/7	3140' underream 6".
1/14	" " "
1/21	Sil. 3140' set 6". T.D. 3151'
	2000' oil in hole.
1/28	P.B. to 3136'. Clean out.
2/4	2000 acid Potential 667
	OVER

1937
2/10

Sil. 3140'.

T. D. 3151'.

1500 acid.

Potential 800.


COMPLETED

KANSAS

Map No. 72 Sec. 25 Twp. 14 R. 15WWell No. 3 HartoughOhio Oil Company

Contractor

SECTION PLAT

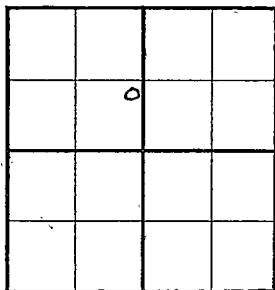 Ft. from N. Line990 Ft. from S. Line330 Ft. from E. Line Ft. from W. Line

FIRST REPORT

Location ✓Rig up

Drilling and Remarks:

RECORD

Cased in., ft.Sand Gas Oil Total Depth

PRODUCTION

1st 24 hrs. Nat. 1st 24 hrs. after shot Gas Cu. Ft.Dry Hole Abandoned

Date

OCT 21 1936 19

S. J. LEWIS

Scout

Russell KANSAS

Map No. 72 Sec. 25 Twp. 14 R. 15WWell No. 3 HartoughOhio Oil Company

Contractor

SECTION PLAT

	0		

Ft. from N. Line

990 Ft. from S. Line330 Ft. from E. Line

Ft. from W. Line

COMPLETED

Location

Rig up

Drilling and Remarks:

Sil. 31401500 acidPotential800

RECORD

Cased _____ in., _____ ft.

Sand _____

Gas _____

Oil _____

Total Depth 3151

PRODUCTION

1st 24 hrs. Nat. _____

1st 24 hrs. after shot _____

Gas _____ Cu. Ft.

Dry Hole _____

Abandoned _____

Date

FEB 10 1937

19

S. J. LEWIS Scout