

Sec. 26 Twp. 14 R. 16W

Well No. #2 Heyl Farm

Sun Oil Company

Anschutz Drlg. Contractor

SE Dreilling Pool


_____ Ft. from N. Line

990 Ft. from S. Line

_____ Ft. from E. Line

990 Ft. from W. Line

NE SW SW

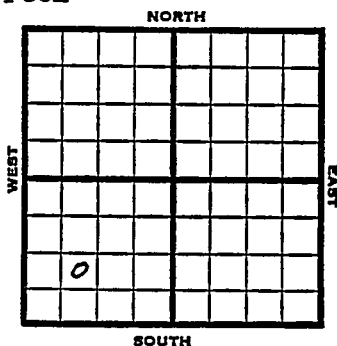

1953 Elev. 1832' REPORT

6/24 Spud 6-17-53
8" @ 704'
Drlg 2618'

7/1 Heeb 3023, Tor 3041, Doug 3056, Lans 3071
DST 3073-3112, 2 hrs., 440' gas, 40' HO&GCM, 60' O&MCSW
DST 3322-49, 2 hrs., 290' HOCM, 200' gas, 675#
Arb. 3324

7/8 RTD 3361
5" @ 3361'
CO Testing.

7/22 NR

7/29 Spud 6-17-53 Oil well TD 3361
8" @ 704' Heeb 3023 Tor. 3041
Doug 3056 Lans 3071
DST 3073-3112 open 2 hr rec 440' gas, 40' HO & GCM, 60' O & MCSW 440#
DST 3322-49 open 2 hr rec 290' HOCM 200' gas 175# Arb. 3324 TD 3361
5" @ 3361 CO to 3330 64/3072-88
S/1 GO 1 GWPH 4½ hr. 2000 A
S/28 BO 42 BW 4½ hrs. S/125 BO
111 BW 30 hr. S/327 BO 64 BW 12 hrs.
Comp. 176 BOPD 20% wtr.

COMPLETED

