


Ellis

KANSAS

SECTION 26 TOWNSHIP 14 RANGE 16W

WELL NO. #1 Wagner

COMPANY Jones, Shelburne & Farmer

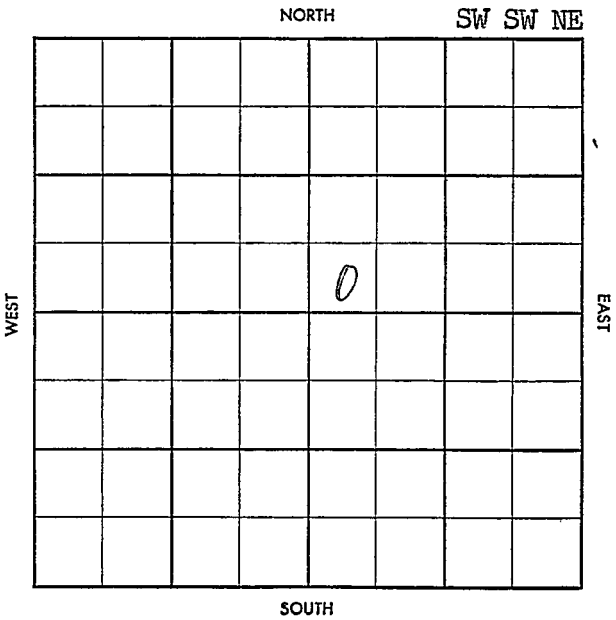



S-513-A

CO. ELLS

ELEV. 1848

BLT 2 57

ABANDONED

SEC. 26

TWP. 14

RGE. 16W

COMPANY Jones, Shelburne No. 1

OCT 16 57

& Farmer

FARM Wagner

LOC. SW SW NE

A 938
Hb 3050
TR 3068
L 3098
BKC 3293
C 3340
TD 3390

GEOL. \_\_\_\_\_

CONTR. Co. Tools

POOL. Ext. Drilling Str.

SPUD: 9-28-57

8" & 9 1/4" w/425, Drly.

1615. ~~1103~~ 112980

1115 57 DST 3082

3110 60' 15M

520' BHP

860-0 DST

3110-3131 30" 70' M BHP

G-720 DST 3180-3205

30" 25' M BHP 960-1020 15ST

3248-95 30" 10' M BH 700-0

no log

~~P 6 A~~

NO. SEC. TWP. RGE.

NO. SEC. TWP. RGE.