

Russell


Section 26 Township 14 Range 15-W

Well No. 2 Brown Waudby

Company Lario et al

NORTH

9

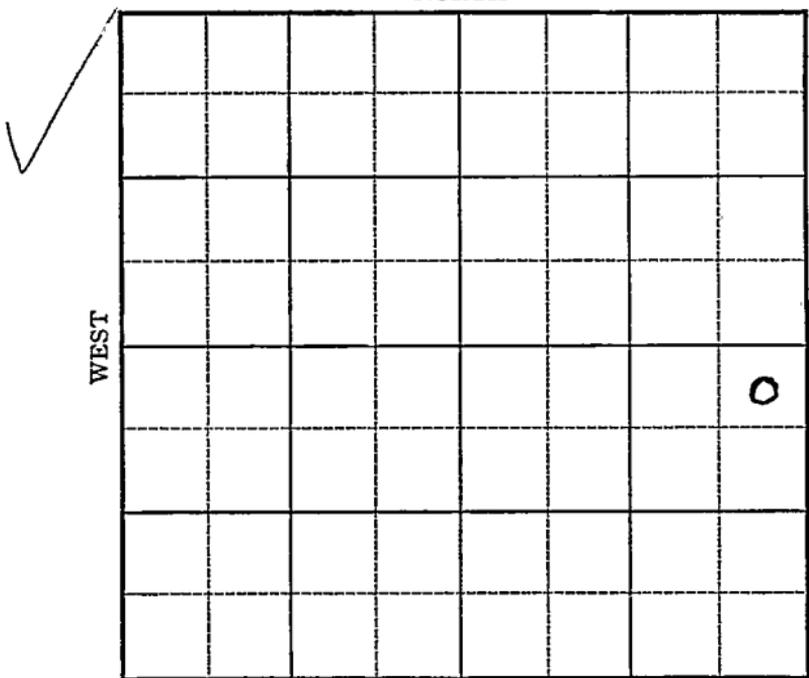


SOUTH

✓

Sec. 26 Twp. 14 R. 15-7

Well No. #2 Brown Waudby Farm
Lario et al Company

330 Ft. from N. Line
 _____ Ft. from S. Line
330 Ft. from E. Line
 _____ Ft. from W. Line
 Elev. 1746

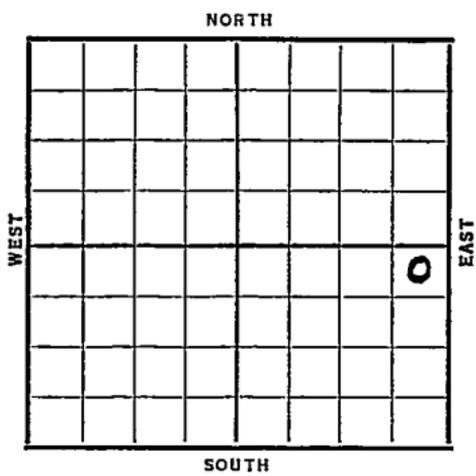

Date	REPORT
1937	
11/3	B. R.
11/12	15" @ 48'. Anhy 770'. Drl g. 798'.
11/19	10" @ 788'. Drl g. 1910'.
11/26	Drl g. 2938'.
12/1	Dolomite 3176'.
	Basal Sand 3178'.
	T.D. 3195'.
	ABANDONED

Russell **KANSAS**Map No. _____ Sec. **26** Twp. **14** R**15W**Well No. **2 Brown Waudby****Lario etal**

Company

Contractor

FIRST REPORT**SECTION PLAT****NE SE****330** Ft. from N. Line

_____ Ft. from S. Line

330 Ft. from E. Line

_____ Ft. from W. Line

			①

Location _____

Rig up _____

Drilling and Remarks:

BR**RECORD**

Cased _____ in., _____ ft.

Sand _____

Gas _____

Oil _____

Total Depth _____

PRODUCTION

1st 24 hrs. Nat. _____

1st 24 hrs. after shot _____

Gas _____ Cu. Ft.

Dry Hole _____

Abandoned _____

Date

NOV 3 1937 19**H. D. Hatfield** Scout

Russell KANSAS

Map No. 72 Sec. 26 Twp. 14 R. 15W

Well No. 2 Brown Waudby

Lario etal

Company

Contractor

ABANDONED

NE SE

330 Ft. from N. Line

_____ Ft. from S. Line

330 Ft. from E. Line

_____ Ft. from W. Line

SECTION PLAT

			0

Location _____

Rig up _____

Drilling and Remarks:

DVA

RECORD

Cased _____ in., _____ ft.

Sand Dolomite 3176

Gas Basal sand 3178

Oil _____

Total Depth 3195

PRODUCTION

1st 24 hrs. Nat. _____

1st 24 hrs. after shot _____

Gas _____ Cu. Ft.

Dry Hole _____

Abandoned _____

Date

DEC 1 - 1937

19

H. D. Hatfield

Scout