

Section 26 Township 14 Range 15-W


Well No. #3 Wadby

Company Lario et al

Trapp Pool

NORTH

2

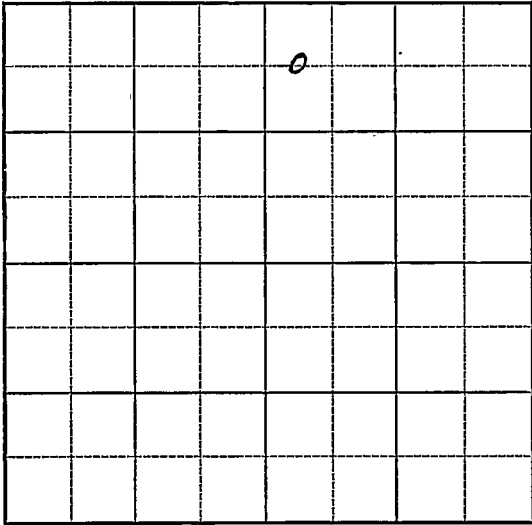

SOUTH

WEST

EAST

Sec. 26 Twp. 14 R. 15-W

Well No. #3 Waddy Farm

Lario et al Company

(Trapp)


660 Ft. from N. Line

_____ Ft. from S. Line

_____ Ft. from E. Line

330 Ft. from W. Line

Elev. 1750

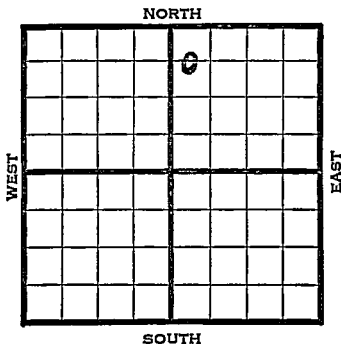

1941	REPORT
4/23	Rotary.
5/1	Anhy 782' 8" - 809'
	Drlg. 1515'
5/8	Gorham 3168 1/2 ^{3168 1/2} T.D. 3171 3170'
	Run casing.
5/15	Gorham 3168 1/2' (Corrected)
	5" - 3168 1/2' T.D. 3170'
	1325' oil 1/2 hour.
5/21	Gorham 3168 1/2'
	5" - 3168 1/2'
	T.D. 3170'
	Depthograph potential 1954 bbls.
	39. Gravity
	COMPLETED

Map No. 72 Sec. 26 Twp. 14 R. 15WWell No. 3 WadbyLario etal

Company

FIRST REPORT

Contractor

SECTION PLAT

C W L NW NE

660 Ft. from N. Line

_____ Ft. from S. Line

_____ Ft. from E. Line

330 Ft. from W. Line

		o	

TRAPP POOL

Location _____

Rig up _____

Drilling and Remarks:

Rotary

RECORD

Cased _____ in., _____ ft.

Sand _____

Gas _____

Oil _____

Total Depth _____

PRODUCTION

1st 24 hrs. Nat. _____

1st 24 hrs. after shot _____

Gas _____ Cu. Ft.

Dry Hole _____

Abandoned _____

Date

APR 23 1941 19

S. J. LEWIS Scout

Map No. 72 Sec. 26 Twp. 14 R. 15W

Well No. 3 Wadby

Lario etal Company

Contractor

COMPLETED

SECTION PLAT

C W L NW NE

660 Ft. from N. Line

_____ Ft. from S. Line

_____ Ft. from E. Line

330 Ft. from W. Line

		o	

TRAP P POOL

Location _____

Rig up _____

Drilling and Remarks:

Go down 3168 1/2

5" @ 3168 1/2

Dept. H. 28 1954

390 ft

RECORD

Cased _____ in., _____ ft.

Sand _____

Gas _____

Oil _____

Total Depth 3190

PRODUCTION

1st 24 hrs. Nat. _____

1st 24 hrs. after shot _____

Gas _____ Cu. Ft.

Dry Hole *hA* _____

Abandoned _____

Date

MAY 21 1941 19

S. J. LEWIS Scout