
FORM 51 25M 3-49 PETROL Russell KANSAS

Section 26 Township 14 Range 15W

Well No. #1 Waudby

Company Lario Oil

14

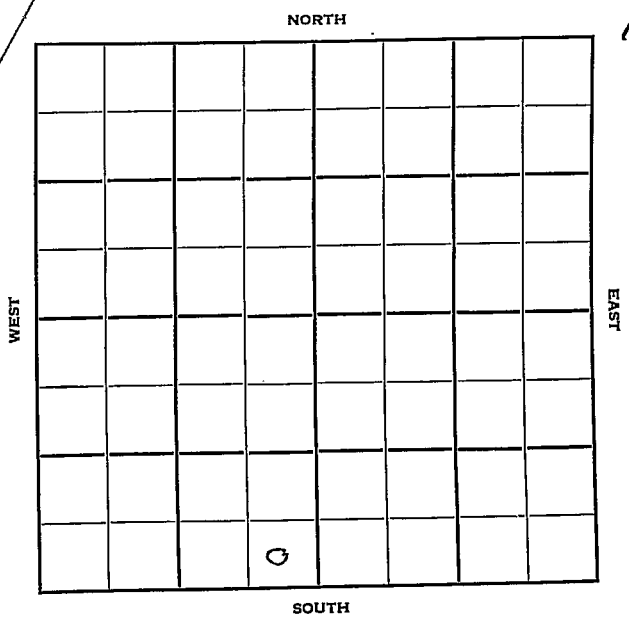

FORM 252-B
10M 8-51 TPCO.

Russell KANSAS ✓

Sec. 26 Twp. 14 R. 15W

Well No. #1 Waudby Farm

Lario Oil Company

Contractor


Ft. from N. Line

330' Ft. from S. Line

330' Ft. from E. Line

Ft. from W. Line

SE SE SW

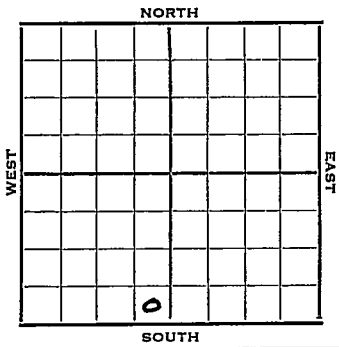

1952	Elev. 1841' REPORT
9/17	Spud 9-7-52 8" @ 870 Topeka 2746 DST 2849-66 1 hr. 6' M DST 2889-2913 1 hr. 10' M Drlg. 2933
9/24	Spud 9-7-52 D&A TD 3348' 8" @ 870' Top 2746 DST 2849-66 open 1 hr. rec. 6' mud DST 2889-2913 open 1 hr. rec. 10' mud Heeb. 2967 Dodge 2986 Lans. 3024 DST 3081-3111 open 1 hr. rec. 215' sw 600# DST 3209-21 open 1 hr. rec. 17' mud 0# DST 3250-73 open 1 hr. rec. 8' mud 0# DST 3251-78 open 1 hr. rec. 90' mud 320# DST 3250-95 open 1 hr. rec. 590' SW 910# Arb. 3290 TD 3348'. D&A

ABANDONED

FORM 275 FOR SALE BY KANSAS BLUE PRINT CO.


County Russell State Kansas

Sec. 26 (Blk. Twp.) 14 (Sur. Rge.) 15W Map No.

Operator Iario Oil

Well No. 1 Farm Weudby

Elev. Location SE SE SW

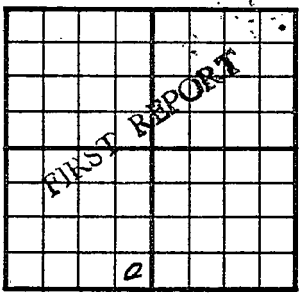

330 Ft. From S Line SW

330 Ft. From E Line Quarter

1st. Report SEP 17 1952

Completion

Remarks

Spudding Date 9-7-52

Drlg. Data

8" @ 870 Topeka 2746 DST 2849-66 1hr.

6"M DST 2889-2913 1hr. 10"M Drlg. 2933

J. G. McGEHEE

FORM 275 FOR SALE BY KANSAS BLUE PRINT CO.


County Russell State Kansas

Sec. 26 (Blk. Twp.) 14 (Sur. Rge.) 15W Map No.

Operator Lario Oil

Well No. 1 Farm Waudby

Elev. 1841 Location SE SE SW

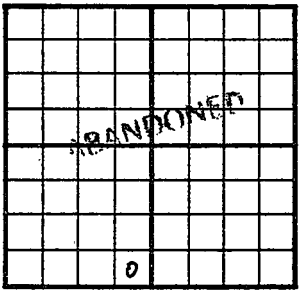

330 Ft. From S Line SW

330 Ft. From E Line Quarter

1st. Report

Completion SEP 2 4 1952

Remarks

Spudding Date 9-7-52

Drlg. Data D & A TD 3348

8" @ 870 Top. 2746 DST 2849-66 open 1 hr. Rec. 6' mud DST 2889-2913 open 1 hr. Rec. 10' mud Heeb. 2967 Dodge 2986 Lans. 3024 DST 3081-3111 open 1 hr. Rec. 215' sw 600# DST 3209-21 open 1 hr. Rec. 17' mud 0# DST 3250-73 open 1 hr. Rec. 8' mud 0# DST 3251-78 open 1 hr. Rec. 90' mud 320# DST 3250-95 open 1 hr. Rec. 590' sw 910# Arb. 3290 TD 3348

D & A

J. G. McGEHEE