
KANSAS Russell

FORM 51 25M 3-49 PETROL

Section 26 Township 14 Range 15-W

Well No. #3 Waudby

Company Tom Palmer

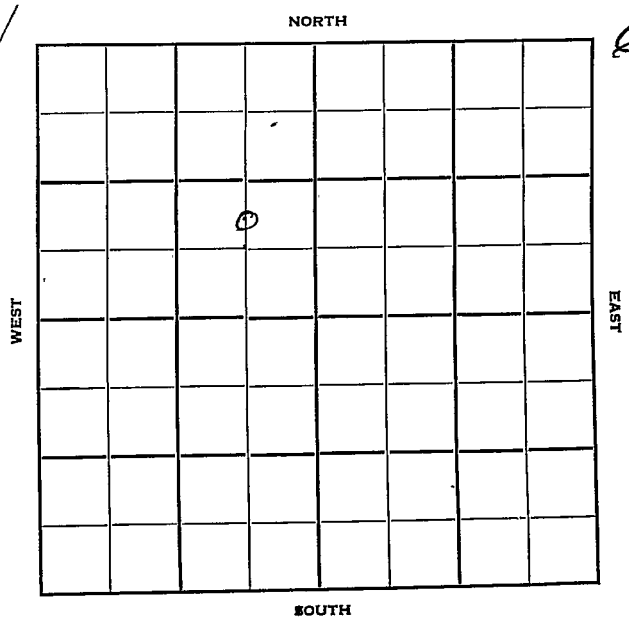

FORM 252-A
5M 10-48 PETROL


KANSAS

Sec. 26 Twp. 14 Russell R. 15W

Well No. #3 Waudby Farm

Tom Palmer Company

Big Creek Pool

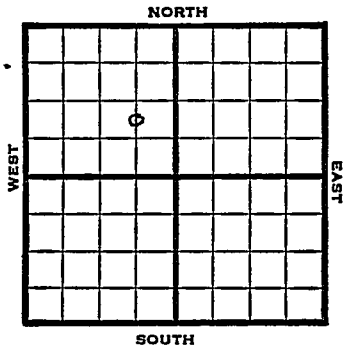

Ft. from N. Line

990' Ft. from S. Line

660' Ft. from E. Line

Ft. from W. Line

C N L SE NW

1950	Elev 1864' REPORT
1/11	Location
2/1	TD 3310 in Cong. 8"@ 800' Top 2774' Lans 3048' Cong 3283' D&A Aband.

ABANDONED

Form 26 200 Bks. 6-49 Petrol

Kansas

Big Creek Pool

Map No. _____ Sec. 26 Twp. 14 R. 15W


Well No. 3 Waudby

Tom Palmer Company

Contractor

C N L SE NW

SECTION PLAT

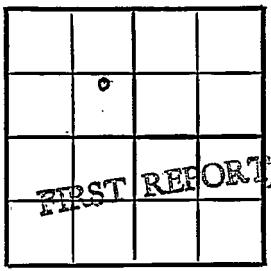

_____ Ft. from N. Line

990 Ft. from S. Line

660 Ft. from E. Line

_____ Ft. from W. Line

Russell County

Location x

Rig up _____

Drilling and Remarks:

RECORD

Cased _____ in., _____ ft.

Sand _____

Gas _____

Oil _____

Total Depth _____

PRODUCTION

1st 24 hrs. Nat. _____

1st 24 hrs. after shot _____

Gas _____ Cu. Ft.

Dry Hole _____

Abandoned _____

Date

JAN 11 1950 19 J. E. TYRA Scout

Form 26 200 Bks. 11-49 Petrol Kansas Big Creek Pool

Map No. Sec. 26 Twp. 14 R. 15W

Well No. 3 Waudby


Tom Palmer Company

Contractor

C N L SE NW

El 1864

SECTION PLAT

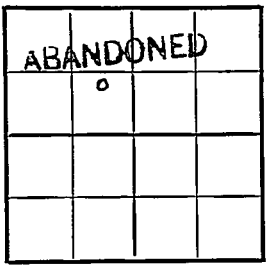

Ft. from N. Line

990 Ft. from S. Line

660 Ft. from E. Line

Ft. from W. Line

Russell County

Location

Rig up

Drilling and Remarks:

8" @ 800
Top 2774
Lans 3048
Conq 3283
D & A

RECORD

Cased in., ft.

Sand

Gas

Oil

Total Depth 3310 in Conq.

PRODUCTION

1st 24 hrs. Nat.

1st 24 hrs. after shot

Gas Cu. Ft.

Dry Hole

Abandoned

Date

FEB 1 1950

19

J. E. TYRA

Scout