

Section 26 Township 14 Range 14W

Well No. #8 Herbel

Company Alva Billings

Hall-Gurney

NORTH

13

WEST

EAST

0							

SOUTH

KANSAS

Russell



Sec. 26 Twp. 14 R. 14W

Well No. #8 Herbel Farm

Alva Billings Company


Hall-Gurney

Ft. from N. Line

330 Ft. from S. Line

Ft. from E. Line

330 Ft. from W. Line

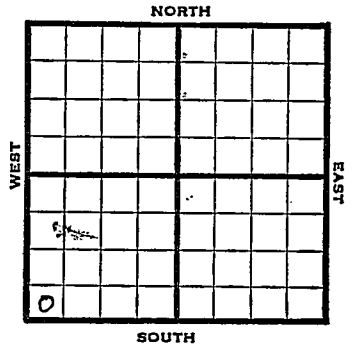

SW/C

1947	Elev. 1778'	REPORT
10/15	Location	
10/22	Rig	
10/29	"	
11/5	"	
11/12	"	
11/19	"	
11/25	"	
12/3	"	
12/10	"	
12/17	"	
12/30	"	
1948	"	
1/7	"	
1/14	"	
1/21	"	
1/26	"	
2/4	"	
2/11	"	
2/18	"	
2/25	Drlg. 390'	
3/3	10" @ 940'	
	Drlg. 1610'	

OVER

1948

3/10 2005' SD for 8"

3/17 "

3/24 8"@2090'
Drlg. 2135'

3/31 Drlg. 2450'

4/7 Drlg. 2450'

4/14 Run 8"

4/21 8" @ 2450'
Lansing 2925'
Drlg. 2950'

4/28 Conglomerate 3171'
TD 3177'
Run Csg.

5/5 Gorham 3171'
5" @ 3171'
Pump 40 Fot.
Gr. 40.9°
TD 3178'

COMPLETED

Map No. _____ Sec. 26 Twp. 14 R. 14thWell No. 8 HerbelAlva Billings Company**FIRST REPORT** Contractor


SW/C

SECTION PLAT

_____ Ft. from N. Line

330 Ft. from S. Line

_____ Ft. from E. Line

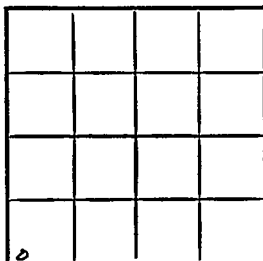330 Ft. from W. LineRussell CountyLocation X

Rig up _____

Drilling and Remarks:

1
 2
 14

Misc Small Maps

Cards *Litho*

Tracing

France Map

Scarborough Map

Pierce Map

Geological Dept.

Pierce Plat Book

Map No. 72 Sec. 26 Twp. 14 R. 14W

Well No. 8 Herbel

Alva Billings Company

COMPLETE Contractor

SW/C

E 11778
 SECTION PLAT

 Ft. from N. Line

330 Ft. from S. Line

 Ft. from E. Line

330 Ft. from W. Line

Russell County

Location

Rig up

Drilling and Remarks:

Logham 8171
5' @ 8171
Pump 40 Pst
40 Pst

RECORD

Cased in., ft.

Sand

Gas

Oil

Total Depth 3178

PRODUCTION

1st 24 hrs. Nat.

1st 24 hrs. after shot

Gas Cu. Ft.

Dry Hole

Abandoned

Date

MAY 5 1948

S. J. LEWIS Scout

100












Misc. Small Maps

Cards

Tracing

France Map

Scarborough Map

Pierce Map

Geological Dept.

France Flat Book

100