
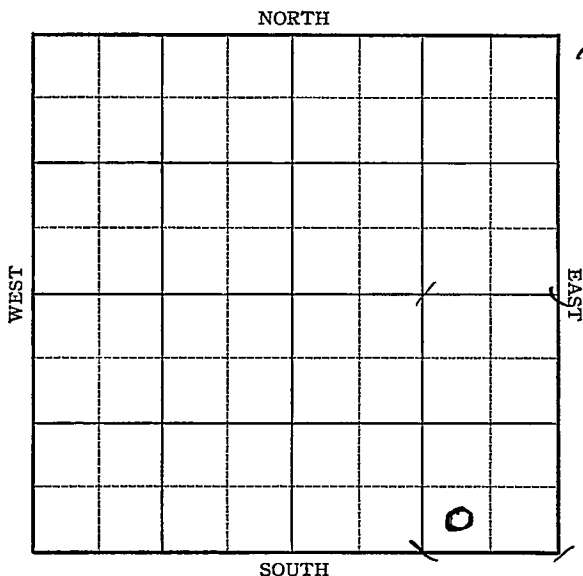


Section 26 Township 14 Range 14-WWell No. 1 Jewel BoxbergerCompany Central Petroleum

Well No. #1 Jewel Boxberger Farm

Elev. 1770

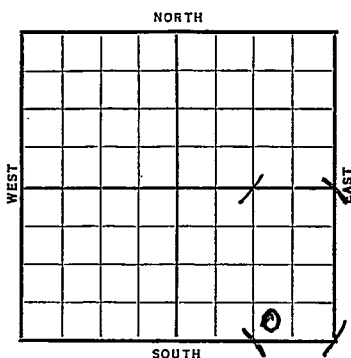

Date	REPORT
1937	
11/3	B. C. R.
11/12	15" @ 52'. SD @ 390'.
11/19	" " " "
11/26	12" @ 440'. Anhy 743'.
	10" @ 754'. 8" @ 2110'.
	Drlg. 2250'.
12/3	8" @ 2360'. Drlg. 2590'.
12/10	Topeka 2620'. S.O. 2630-2632'.
	S.W. 2925-30'. K.C. 2914'.
	7" @ 2933'. WOC.
12/17	T.D. 3010'. 2000' oil.
	10,000 acid.
	OVER

1937

12/22 7" @ 2933'.

K.C. 2914'.

T.D. 3010'.

10,000 acid.

Potential 3049 bbls.

COMPLETED

KANSAS

Russell

Map No. _____ Sec. 26 Twp. 14 R14WWell No. 1 Jewel BoxbergerCentral Petroleum Company

Contractor

FIRST REPORT


SW SE SE

_____ Ft. from N. Line

330 Ft. from S. Line990 Ft. from E. Line

_____ Ft. from W. Line

SECTION PLAT

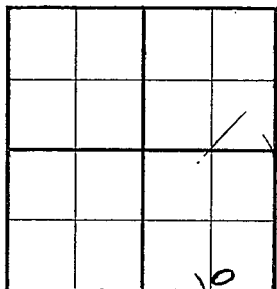

Location _____

Rig up _____

Drilling and Remarks:

BCR

RECORD

Cased _____ in., _____ ft.

Sand _____

Gas _____

Oil _____

Total Depth _____

PRODUCTION

1st 24 hrs. Nat. _____

1st 24 hrs. after shot _____

Gas _____ Cu. Ft.

Dry Hole _____

Abandoned _____

Date

NOV 3 1937

19

H. D. Hatfield

Scout

RAY

Returned	
to	Paul
by	JMC
on	RAY
at	
Moody	
Seal	
Moody	

Russell KANSAS

Map No. 72 Sec. 26 Twp. 14 R. 14WWell No. 1 Jewel BoxbergerCentral Petroleum Company

Contractor

COMPLETED**SECTION PLAT**

SW SE SE

Ft. from N. Line

330 Ft. from S. Line990 Ft. from E. Line

Ft. from W. Line

			0

Location _____

Rig up _____

Drilling and Remarks:

*10,000 acid**POT-3049***RECORD**Cased 7 in., 2933 ft.Sand K.C. 2914

Gas _____

Oil _____

Total Depth 3010**PRODUCTION**

1st 24 hrs. Nat. _____

1st 24 hrs. after shot _____

Gas _____ Cu. Ft.

Dry Hole _____

Abandoned _____

Date

DEC 22 1937

19

H. D. Hatfield Scout



42 5 2

1. 2. 84


Returned

Cards

1107 73

6.

20

44000 1 20

✓ 11/16/2011

Only F at Book