


Well No. 100 Farm 100
Acro Oil Crown oil Company

NORTH

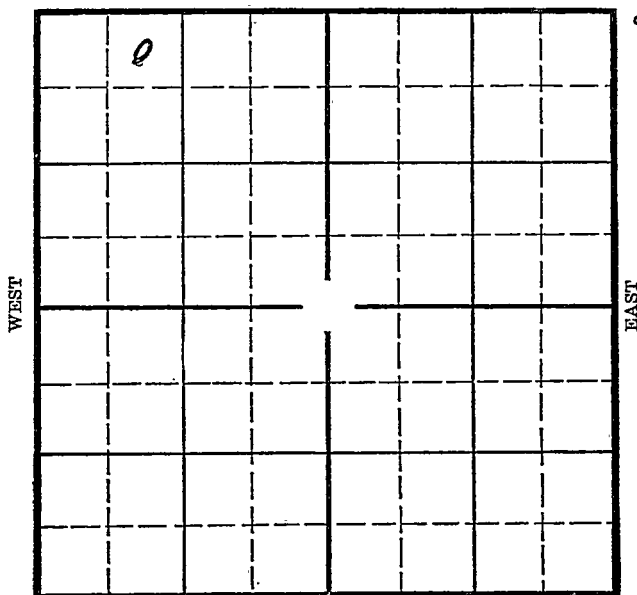

Location

Drilling Remarks

Rig Up

Drilling Remarks

RECORD

Cased 1 in. ft.

Sand.

Gas.

Oil

Total Depth

PRODUCTION

1st 24 hrs. Nat.

1st 24 hrs. after shot.

Gas_____cu. ft.

Dry Hole

Abandoned

Russell

Map No. KANSAS Sec. 26 Twp. 14 R. 14W

Well No. 7-~~Krug~~ #1 ~~Krug~~ Farm Crown Oil Company


330 Ft. from N. Line

_____ Ft. from S. Line

_____ Ft. from E. Line

990 Ft. from W. Line

Elev. 1798

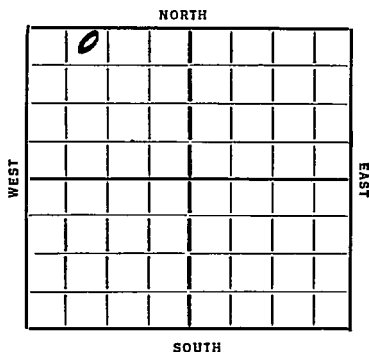

Date	REPORT
12/31	Callan & Ponds
12/18	12/26
12/36	Spunk 55
1/10	12" 410 T.D.
1/17	12" 450 Aubrey 795
	10" 820 Bly 1165
1/24	
1/31	Bly 2190 8" 2135
2/7	8" 2410 T.D. CO
2/14	so 2340-47
	T.D. 2384 fig
2/21	S.D.
2/28	Bly 2680 so 2670-75
3/6	T.D. 2940 CO
3/13	6"-2959 Show oil 2963-71 T.D. C.O.
3/20	6"- 2971 Pay 3025-40 T.D. 3 bbls. oil per hr. 1000gallons acid. WOC.
3/27	Pumped 8 bbls per hour 5000 acid.
4/2	--

(OVER)

4/8 Pay 3025-40
TD 3040
5000 acid
pump 485 Bbls.

COMPLETED

KANSAS

Map No. 72 Sec. 26 Twp. 14 R. 14W

Well No. 1 - Krug

Crown Oil Company

Contractor

SECTION PLAT

330 Ft. from N. Line

..... Ft. from S. Line

..... Ft. from E. Line

990 Ft. from W. Line

CORRECTION

0			

Location

Rig up

Drilling and Remarks:

* 1st reported as
Saco Oil Co. #2 Krug

RECORD

Cased in., ft.

Sand

Gas

Oil

Total Depth

PRODUCTION

1st 24 hrs. Nat.

1st 24 hrs. after shot

Gas Cu. Ft.

Dry Hole

Abandoned

Date

12-18-35 192... ORVAL MANNSCHRECK Scout

Returned _____
Cards _____
Tracing _____
France Map _____
Scarborough Map _____
Moody Map _____
Scarborough Plat Book _____
Moody Plat Book _____

Map No. 72 Sec. 26 Twp. 14 R. 14W

Well No. 2 - Krug

Saco Oil Company

Contractor

SECTION PLAT

330 Ft. from N. Line

..... Ft. from S. Line

..... Ft. from E. Line

990 Ft. from W. Line

0			

Location.....

Rig up.....

Drilling and Remarks:

Cellar & Ponds

RECORD

Cased..... in., ft.

Sand.....

Gas.....

Oil.....

Total Depth.....

PRODUCTION

1st 24 hrs. Nat.....

1st 24 hrs. after shot.....

Gas..... Cu. Ft.

Dry Hole.....

Abandoned.....

Date

12-11-35 192..... Scout

ORVAL WATSON

no wall map

Returned	
Cards	<i>GP</i>
Tracing	<i>GP</i>
France Map	<i>X</i>
Scarborough Map	<i>X</i>
Moody Map	<i>X</i>
Scarborough Plat Book	
Moody Plat Book	

Map No. 72 Sec. 26 Twp. 14 R. 14Well No. 1 KingCrown Oil Company

Contractor

SECTION PLAT

320 Ft. from N. Line

Ft. from S. Line

Ft. from E. Line

990 Ft. from W. Line

0	.		

COMPLETED

Location

Rig up

Drilling and Remarks:

Pay 3025-406000 acid.Pump 485 8/10

RECORD

Cased in, ft.

Sand

Gas

Oil

Total Depth 3040

PRODUCTION

1st 24 hrs. Nat.

1st 24 hrs. after shot

Gas Cu. Ft.

Dry Hole

Abandoned

Date

4/8/36 192

S. J. LEWIS

Scout

Annual report

Returned	_____
Cards	_____
Trac	_____
File	_____
Copy	_____
Index	_____
Other	_____
Total	_____