


SECTION 26 TOWNSHIP 14 RANGE 14W

WELL NO. #1 Krug

COMPANY Aylward Drlg.

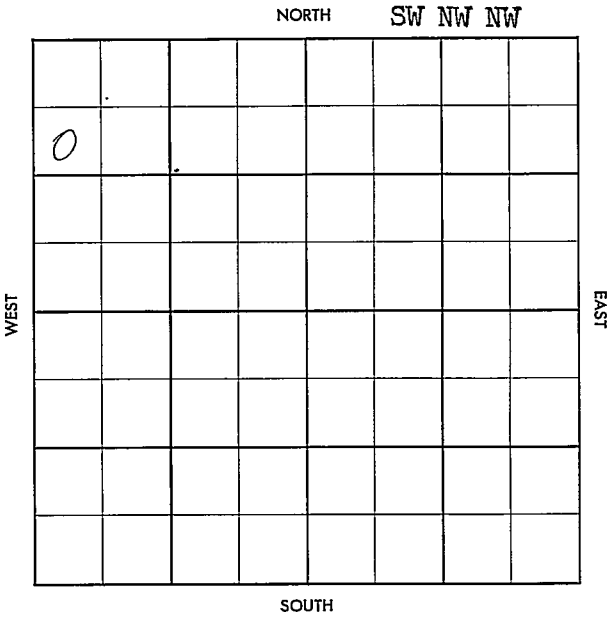



Co.

County Russell Elev. \_\_\_\_\_  
 Sec. 26 Twp. 14 Rgs. 14  
 Company Aylward Drlg.  
 Farm Name Krug No. 1

TOPS	DEPTH	LOG	DATUM	Loc in Sec.
Anh.				SW NW NW
TP.				
H.				
Tr.				
Dg.				
Bl.				
L. Tankio	2336			Geol. _____
K.C. 2"	2354			Contr. _____
B.K.C. TANKIO	2397			
Ce. 3d	2431			
C. TP	2659			
M. HK	2887			Pool _____
M. TR	2907			
K. L59	2950			Hall-Gurney
Mz.				
Me.				
V.				
S.				
S.				
A.				
R.				
PE.				
G.				
T.D.	2952			

Lse.

No.

Sec.

T.

R.

Date Comm. 5-8-57

8" @ 300/200, cored 2330-62 rec 32',  
 Drlg. 2745 MAY 22 '57 pipe set MICT  
 MAY 29 '57 5 1/2 2951/150 RD 2997  
 1st 3 Boph + TR. WT  
 DD 3061 JUN 5 '57 JUN 2 '57 \$  
 4 Boph netw est P.  
 50 Boph netw

COMPLETE

JUN 12 '57